

Pearl River
 H 2
 5-5-69

MISSISSIPPI
 BOARD OF WATER COMMISSIONERS
 416 North State Street
 Jackson, Mississippi 39201

WATER WELL DRILLERS LOG

5-5-1969 date well completed Horace A. Poole firm name Pearl River county well located

LANDOWNER: Ervin - Lee
RT# 3 Sumberton
Miss
 (mailing address)

description of formations encountered	from	to
SANDY CLAY	0	30
SAND	30	38
CLAY	38	65
SILT	65	84
SAND + CLAY	84	140
SILT	140	160
HARD SANDY CLAY	160	190
FINE SAND	190	247
CORSE SAND P. & G.	247	272

WELL LOCATION:
 sec. 21 T. 2 N. R. 14 E.
 S. W.
8 1/2 miles East of Poplarville
 (distance) (direction) (nearest town)

WELL PURPOSE: DRAIN FARM
 (home, irrigation, municipal, industrial)

WELL COMPLETION DATA:

(1) diameter (inches) 6 1/2

(2) total depth (feet) 272

(3) static water level (feet) 100 below top of ground.

(4) casing PVC 262 ft.
 (material) (depth)

4 if telescope see back.
 (size)

(5) screen 10 262
 (length) (depth to top)

010 PVC
 (size) (material)

(6) pump 1 10
 (HP) (yield gpm)

Electric
 (type power)

(7) electric log no
 (yes or no)

(organization running log)

(8) how well bottom plugged CLAYTON MARKS

NOV 20 1969


MISS. BD. OF WATER COM.

DRILLERS REMARKS:

2

If well telescopes please sketch and show depths.

GROUND LEVEL

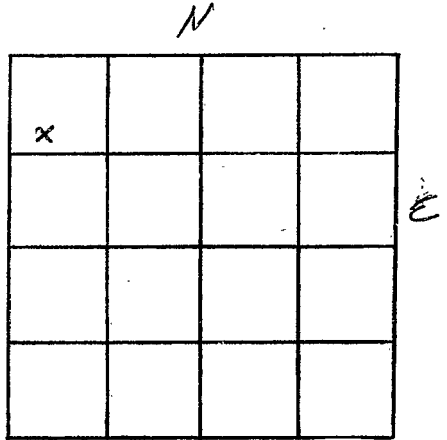

SECTION 21

Please indicate well location X.

ADDITIONAL INFORMATION

*1-H.P. Subm. Pump
set at 180 ft.*

If more than one screen, show locations of each on sketch.