

Pearl River
H 3
5-17-69

MISSISSIPPI
 BOARD OF WATER COMMISSIONERS
 416 North State Street
 Jackson, Mississippi 39201

WATER WELL DRILLERS LOG

5-17- 1969 Home A Pool Pearl River
 date well completed firm name county well located

LANDOWNER: J J Lee
Sumner RT 3
Miss
 (mailing address)

WELL LOCATION:
 sec. 26 T. 2 N. R. 14 E. W.
14 miles E of Poplarville
 (distance) (direction) (nearest town)

WELL PURPOSE: None
 (home, irrigation, municipal, industrial)

- WELL COMPLETION DATA:
- (1) diameter (inches) 4"
 - (2) total depth (feet) 170
 - (3) static water level (feet) 100' below top of ground.
 - (4) casing PVC, 165ft,
 (material) (depth)
 - 2
 (size) if telescope see back.
 - (5) screen 5ft, 165ft,
 (length) (depth to top)
 - 0/0, PVC
 (size) (material)
 - (6) pump 1 1
 (HP) (yield gpm)
 - Electric
 (type power)
 - (7) electric log Yes
 (yes or no)

(organization running log)

(8) how well bottom plugged
Clayton + Mosher Drilling

description of formations encountered	from	to
<u>Loose Clay</u>	<u>0</u>	<u>42</u>
<u>Clay</u>	<u>42</u>	<u>65</u>
<u>Silt</u>	<u>65</u>	<u>85</u>
<u>Hard Clay</u>	<u>85</u>	<u>130</u>
<u>Finer Sand</u>	<u>130</u>	<u>147</u>
<u>Hard Clay</u>	<u>147</u>	<u>150</u>
<u>Med. Sand</u>	<u>150</u>	<u>170</u>


MAY 20 1969

MISS. BD. OF
 WATER COMM.

DRILLERS REMARKS:

If well telescopes please sketch and show depths.

GROUND LEVEL

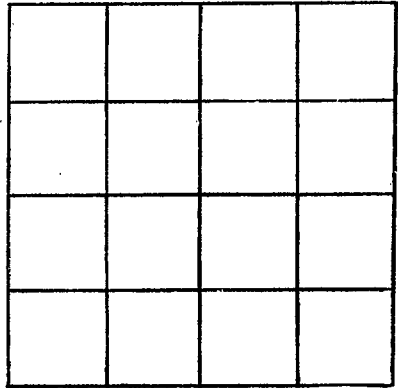

SECTION 26

Please indicate well location X.

ADDITIONAL INFORMATION

If more than one screen, show locations of each on sketch.