

PEARL RIVER
H 8
12-17-71

MISSISSIPPI
 BOARD OF WATER COMMISSIONERS

416 North State Street
 Jackson, Mississippi 39201

FEB - 8 1972

MISS. BD. OF
 WATER CO.

WATER WELL DRILLERS LOG

CODED

Dec. 17 1971 Harold Woodward Pearl River
 date well completed firm name county well located

LANDOWNER: Baley Farms
ht. 3 Poplarville, Miss
 (mailing address)

description of formations encountered	from	to
<u>clay</u>	<u>0</u>	<u>18'</u>

WELL LOCATION:
 sec. 24 T. 2 N R. 14 E
9 miles W of Poplarville
 (distance) (direction) of (nearest town)

<u>sand fine</u>	<u>18</u>	<u>30</u>
------------------	-----------	-----------

WELL PURPOSE:
 (home, irrigation, municipal, industrial)

<u>chance sand & large rock</u>	<u>53'</u>	<u>87'</u>
-------------------------------------	------------	------------

WELL COMPLETION DATA:

(1) diameter (inches) 4"

(2) total depth (feet) 87'

(3) static water level (feet) 33 below top of ground.

(4) casing plastic 77'
 (material) (depth)
 (size) if telescope see back.

(5) screen 10' 77'
 (length) (depth to top)
4" plastic
 (size) (material)

(6) pump 1/2 15
 (HP) (yield gpm)
230 AC
 (type power)


(7) electric log yes or no
Yell
 (organization running log)

(8) how well bottom plugged 2"SS

DRILLERS REMARKS:

If well telescopes please sketch and show depths.

GROUND LEVEL

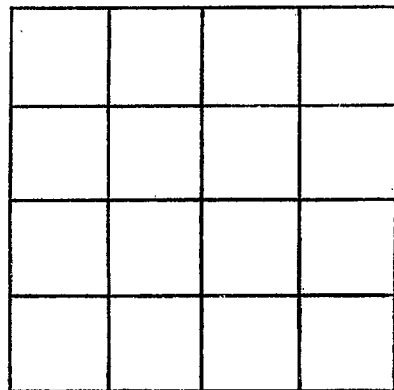

SECTION _____

Please indicate well location X.

ADDITIONAL INFORMATION

If more than one screen,
show locations of each on sketch.