

PEARL RIVER
H9 CODED
9-22-71

MISSISSIPPI
BOARD OF WATER COMMISSIONERS
416 North State Street
Jackson, Mississippi 39201

WATER WELL DRILLERS LOG

9-22 1971 Parnell Anderson Pearl River
date well completed firm name county well located

LANDOWNER: Red Hill Church

Rt 3 Lumberton Miss

(mailing address)

WELL LOCATION:

sec 25 T 2 S R 14 W
14 miles W of Poplarville
(distance) (direction) (nearest town)

WELL PURPOSE:

(home, irrigation, municipal, industrial)

WELL COMPLETION DATA:

- (1) diameter (inches) 2
(2) total depth (feet) 82
(3) static water level (feet) 48 below top of ground.
(4) casing PVC 79 (material) (depth)

(size) If telescope see back.

- (5) screen 5 77 (length) (depth to top)

3 PVC (size) (material)

- (6) pump 1/2 6 (HP) (yield gpm)

Elect (type power)

- (7) electric log (yes or no)

(organization running log)

- (8) how well bottom plugged
Backwash Valve


description of formations encountered	from	to
TOP Soil	0	2
Red Sandy clay	2	26
Red clay	26	38
Fine Sand	38	51
Pink clay	51	60
Sand F.W.	60	68
Coarse Sand	68	76
Gravel & Sand	76	82

DRILLERS REMARKS:

AUG 28 1972

If well telescopes please sketch and show depths.

GROUND LEVEL

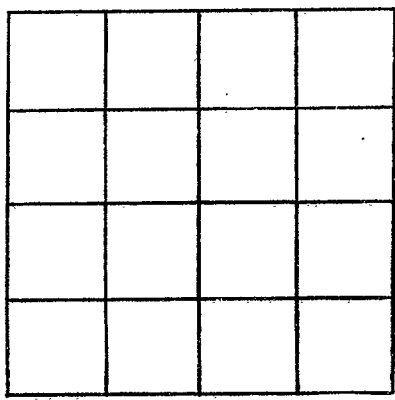

SECTION _____

Please indicate well location X.

ADDITIONAL INFORMATION

Lined area for additional information, consisting of approximately 20 horizontal lines.

If more than one screen, show locations of each on sketch.