

PEARL RIVER
H 10
2-22-72

MISSISSIPPI
BOARD OF WATER COMMISSIONERS
416 North State Street
Jackson, Mississippi 39201

CODED

WATER WELL DRILLERS LOG

2-22 1972 Parnell Anderson Pearl River
date well completed firm name county well located

LANDOWNER: Nathan L Seals
Lumberton MS
(mailing address)

WELL LOCATION:
sec. 12 T. 2 N. R. 14 E
S W
14 miles E of Poplarville
(distance) (direction) (nearest town)

WELL PURPOSE: Home
(home, irrigation, municipal, industrial)

- WELL COMPLETION DATA:
- (1) diameter (inches) 2
 - (2) total depth (feet) 170
 - (3) static water level (feet) 80 below ~~depth~~ top of ground.
 - (4) casing Plastic, 165,
(material) (depth)
(size) if telescope see back.
 - (5) screen 5', 165
(length) (depth to top)
2", Plastic
(size) (material)
 - (6) pump 1, 7
(HP) (yield gpm)
Flot
(type power)
 - (7) electric log (yes or no)
(organization running log)
 - (8) how well bottom plugged Backwash valve

description of formations encountered	from	to
Top Soil	0	2
Sand	2	34
Red clay	34	42
Coarse Sand	42	68
pink clay	68	72
Fine Sand, clay st	72	152
Coarse Sand & gravel	152	170


CODED

DRILLERS REMARKS:

MSD 11 572

If well telescopes please sketch and show depths.

GROUND LEVEL

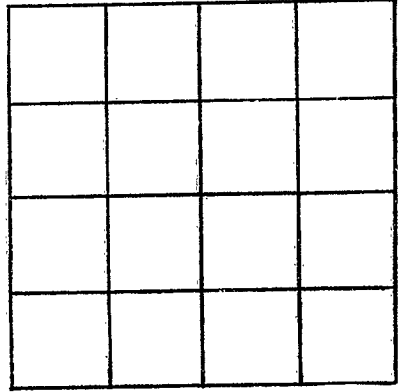

SECTION _____

Please indicate well location X.

ADDITIONAL INFORMATION

Lined area for additional information.

If more than one screen, show locations of each on sketch.