

PEARL RIVER  
H 11  
3-19-73

MISSISSIPPI  
BOARD OF WATER COMMISSIONERS  
416 North State Street  
Jackson, Mississippi 39201

**CODED**

WATER WELL DRILLERS LOG

3-19 1973 PARWELL ANDERSON Pearl River  
date well completed firm name county well located

LANDOWNER:

Rough Carroll Wade

(mailing address)

WELL LOCATION:

sec. 21 T. 2 S. R. 14 E. W.

\_\_\_\_\_ miles \_\_\_\_\_ of \_\_\_\_\_  
(distance) (direction) (nearest town)

WELL PURPOSE: Home  
(home, irrigation, municipal, industrial)

WELL COMPLETION DATA:

- (1) diameter (inches) 2"  
(2) total depth (feet) 85'  
(3) static water level (feet) 68 below above top of ground.  
(4) casing Plastic 63  
(material) (depth)

\_\_\_\_\_ if telescope see back.  
(size)

- (5) screen 5' 63  
(length) (depth to top)  
2" Plastic  
(size) (material)

- (6) pump 1 ?  
(HP) (yield gpm)  
Elect  
(type power)

- (7) electric log no  
(yes or no)

\_\_\_\_\_ (organization running log)

- (8) how well bottom plugged  
Back with 7/8 valve

description of formations encountered

from to

Top Soil	0	6
Shell Clay	6	40
Fine sand	40	65
Coarse Sand	65	85


**CODED**

DRILLERS REMARKS:

NOV 25 1973

If well telescopes please sketch and show depths.

GROUND LEVEL

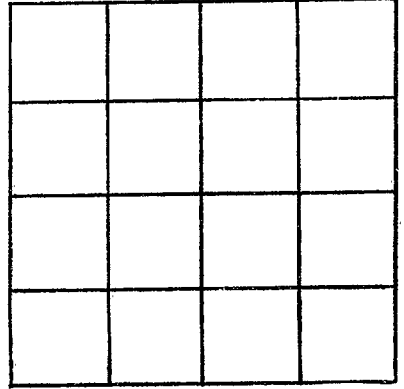

SECTION \_\_\_\_\_

Please indicate well location X.

ADDITIONAL INFORMATION

If more than one screen, show locations of each on sketch.