

P.R.  
 H 13  
 10-12-73

MISSISSIPPI  
 BOARD OF WATER COMMISSIONERS  
 416 North State Street  
 Jackson, Mississippi 39201

CODED

WATER WELL DRILLERS LOG

Oct 12 1973 HORACE A POOLE Pearl River  
 date well completed firm name county well located

LANDOWNER: M.R. See  
Sumberton Miss  
 (mailing address)

description of formations encountered	from	to
<u>Surf Ace Clay</u>	<u>0</u>	<u>18</u>
<u>SANDY Clay</u>	<u>18</u>	<u>30</u>
<u>SAND</u>	<u>30</u>	<u>84</u>

WELL LOCATION:  
 sec 6 T 2 S R 14 W  
10 miles NE of Poplarville  
 (distance) (direction) (nearest town)

WELL PURPOSE: Home  
 (home, irrigation, municipal, industrial)

- WELL COMPLETION DATA:
- (1) diameter (inches) 4 1/2
- (2) total depth (feet) 84
- (3) static water level (feet) 60 below top of ground.
- (4) casing Pvc, 79  
 (material) (depth)  
2" if telescope see back.  
 (size)
- (5) screen 5, 79  
 (length) (depth to top)  
2-010, Pvc  
 (size) (material)
- (6) pump 1, 6  
 (HP) (yield gpm)  
Elec  
 (type power)
- (7) electric log no  
 (yes or no)
- (organization running log)
- (8) how well bottom plugged back wash valve


CODED

DRILLERS REMARKS:

OCT 31 1973

If well telescopes please sketch and show depths.

GROUND LEVEL

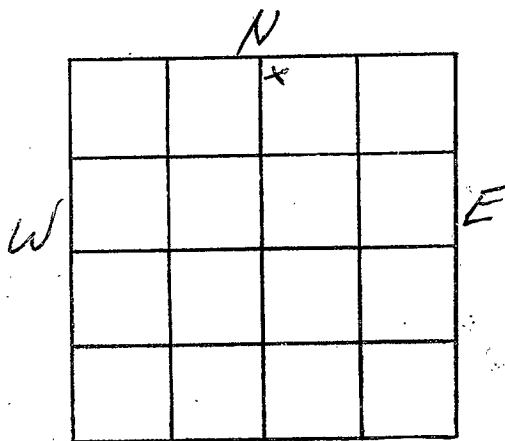

SECTION 6

Please indicate well location X.

ADDITIONAL INFORMATION

If more than one screen, show locations of each on sketch.