

P.R.
 H14
 9-4-73

MISSISSIPPI
 BOARD OF WATER COMMISSIONERS
 416 North State Street
 Jackson, Mississippi 39201

CODED

WATER WELL DRILLERS LOG

9-4 19 73 Bud Penton & Son Pearl River
 date well completed firm name county well located

LANDOWNER: Dakley
Cyprus
Poplarville, Miss.
 (mailing address)

description of formations encountered	from	to
Red Shale	0	33
Red Sand	35	90
White Shale	90	129
White Blue Sand	129	148

WELL LOCATION:
 sec. 12 T. 2 N. R. 14 E.
15 miles SE of Poplar
 (distance) (direction) (nearest town)

WELL PURPOSE: Home
 (home, irrigation, municipal, industrial)

- WELL COMPLETION DATA:
- (1) diameter (inches) 2 1/2
 - (2) total depth (feet) 148
 - (3) static water level (feet) 58 below above top of ground.
 - (4) casing Galv. 1 1/2 (material) (depth)
 - _____ if telescope see back. (size)
 - (5) screen 2 1/2 143 (length) (depth to top)
2 1/2 (size) Stainless Steel (material)
 - (6) pump 1 (HP) 520 (yield gpm)
electric (type power)
 - (7) electric log NO (yes or no)
 - _____ (organization running log)
 - (8) how well bottom plugged Sand Shale

CODED


RECORDED
 INDEXED

JAN 7 1974

DRILLERS REMARKS:

If well telescopes please sketch and show depths.

GROUND LEVEL

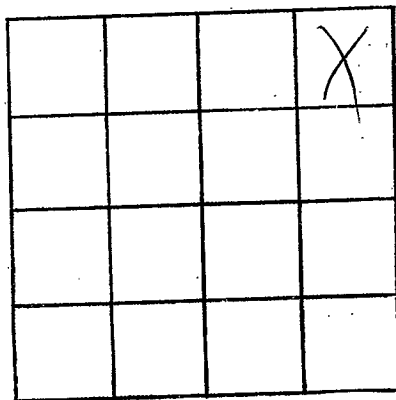

SECTION _____

Please indicate well location X.

ADDITIONAL INFORMATION

If more than one screen, show locations of each on sketch.