State Well Report	
County: Pearl River 109 Part 1 Fo	r Office Use Only:
Mississippi Department of Environmental Quality Aquifer:	
Permit #: Office of Land and Water Resources Well #:	H - 36
Jackson, MS 39289-0631	ation:
Date drilling completed: $\alpha/\alpha.5/0.5$ (601)961-5210	
norres Water Well Service	
State Law requires that this report be prepared by the driller in detail and filed with the De 30 days of completion of drilling of the well.	epartment within
Well Owner Information         Well Location	<u>`</u>
Owner Name_MikeMitchelLatitude:' Longitude:'	de:°'
Mailing Address: 9313 Huy// Method of Lat/Long (circle one): Conver	ntional Survey,
USGS quad, Hand-held GPS, Surv	vey-grade GPS
Popplerielle, MS 3470 14 Sec_ 3 Twn_	
Uity State Zip Code Distance Direction Neare:	st Town
Telephone No. ()     Distance     Direction     Nearest       3_Miles     5	Hsdale_
Well Data	
Purpose of Well (circle one Home Industrial Public Supply Irrigation Fish Culture Other:	•
Date well drilling started: $2/24/05$ Date well drilling completed: $2/25/0$	5-
If flowing, method of flow regulation: Valve Other (describe)	
Static Water Level: <u>28</u> feet above or below (circle one) and surface Date measured: <u>2/2</u>	1705-
Method of Measurement (circle one) steel tape electric tape air line other:	
Hole depth: <u>55</u> Well depth: <u>55</u> Well grouted to a depth of <u>10</u>	feet
Type of grout (circle one): Cement Bentonite Mix	
Casing length: <u>56</u> feet Casing diameter: <u>2</u> inches Type of casing: <u>PVC.S</u>	
Screen length: <u>3</u> feet Screen diameter: <u><math>2052</math></u> inches Type of screen: <u><math>PVCSc</math></u>	chy0
Screen slot size: <u>.08</u> inches Setting depth: From <u>50</u> feet to <u>55</u>	feet
Type of completion (circle all applicable): Gravel packed Underreamed Telescoped Open hole Nat	tural Development
Other (describe):	
Top of lap pipe or reduction in casing:feet. If telescoped or more than one screen, describ	e on back of page
Logs run (circle all applicable): No log run Electric Gamma Ray Density Sonic Neutron Other: 5	•
Name of organization running log(s):	
I certify that the well was drilled, constructed, and completed in accordance with all applicable requirement	ts of the Mississippi
Department of Environmental Quality and/or the Mississippi Department of Health regulations and state la	ws.
Arnold Ray Moore 0533 Quald Ray 6	mostl
the second filling and a second of the	marce


RECEIVED MAR 1 5 2005 BY: OLWP

please sketch below and show depths. If well tel

Ground L

red clay 2' 1	el	Description of Formations Encountered	From To
White Garse Sand 18' St white Garse Sand 18' St 		 +00 Soil	112
White Garse Sand 18' St white Garse Sand 18' St 		red clay	
		whitesoupstone	
		white course sand	<u> </u>
			<u> </u>
		, , , , , , , , , , , , , , , , , , ,	
		······································	

If more than one screen, show location of each on sketch

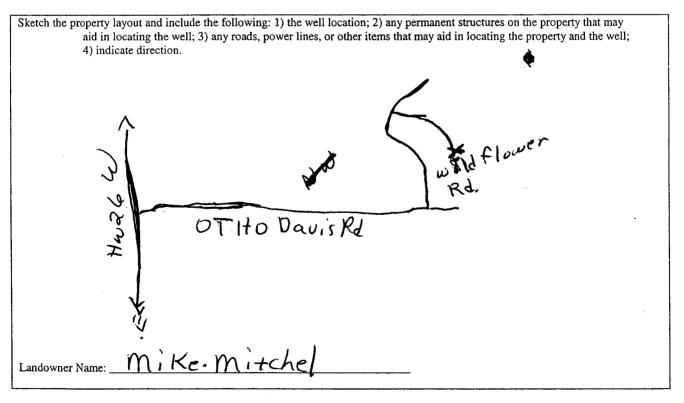

moore arm

Signature of Water Well Contractor

RECEIVED MAR 1 5 2005 BY: OLWR

•		STATE W	ELL REPORT	.*	
0	IP		Part 2	For Office Use Only:	
County: Pear			's Completion Report nt of Environmental Quality	Aquifer:	
Permit #:		Office of Land	and Water Resources		
Driller:	·········		Box 10631 MS 39289-0631	Well #: 436	
Date completed:	125/05		)961-5210		
	/ ····	(601)3:	54-6938 (fax)	Elevation:	
This report sh installation of	pump.		ail and filed with the Departme	ent within 30 days of the	
	Well Owner Inform	nation	We	ell Location	
Owner Name:	like Mit	tchel	Latitude:Longitude:		
Mailing Address:	9313 H	vy11	Method of Lat/Long (circle one): Conventional Survey,		
		, 	USGS quad, Hand-held GPS, Survey-grade GPS		
	City pelar M	$\frac{M}{M} \frac{MS 3470}{Zip Code}$	<sup>1</sup> /4 <sup>1</sup> /4 Sec	<u>3 Twn 25 Rng 14</u> K	
	, 544		Distance Direction	Nearest Town	
Telephone No. (	)		3_Miles East	of Hillsdale	
	Ритр Туре	₩ <u>* ₩</u> *₩*₩*₩ <del>8*¥*</del> +1	D.	ower Type	
	Circle one			Circle one	
Air Lift	Let	Submersible	Diesel Engine Gasol	ine Engine Natural Gas	
Bucket	Piston	Turbine	Electric Motor Hand	Tractor PTO	
Centrifugal	Rotary	Flowing Well	1	(specify):	
		· · · ·	Horse Power Rating of Moto	r: phr.	
Date Pump Installe	d: <u>2/257</u>	05	Setting Depth:	feet	
Rated Pump Capac	ity: <i>(e</i>	Gallons Per Minute	Number of Stages:2	2	
	Pump Test Dat	a	Method of M	easuring Water Level	
Date Well Tested:				Circle one	
Date Well Tested: Static Water Level (A):Feet Below Land Surface		Air Line Electric Me	easuring Line Steel Tape		
Pumping Water Level (B):Feet Below Land Surface			Other (specify):		
Drawdown [(B) – (	A)]:Fe	eet Below Land Surface	For flowing well, measured s	shut in head:feet	
Test Pumping Rate	le	Gallons Per Minute	Well yielded	GPM with a drawdown of	
Duration of Pump	Fest (minimum 4 hour	s):hours	feet after	hours of pumping	
		· · · · · · · · · · · · · · · · · · ·			
IHEREBY CERTI Arnold	.0	ements are true to the best $(1)$	of my knowledge.	1 moore	
	Ray Mo.		Signature of Pump I	·	

MAR 1 5 2005 BY: OLWR