

FEB-23-2002 05:53A FROM:

TO:16013600535

P:1

### State Well Report

#### Part 1

Mississippi Department of Environmental Quality  
 Office of Land and Water Resources  
 P.O. Box 10631  
 Jackson, MS 39289-0631  
 (601)961-5210  
 (601)354-6938 (fax)

#### For Office Use Only:

Aquifer: \_\_\_\_\_  
 Well #: H-44  
 L. S. Elevation: \_\_\_\_\_  
 E-log #: \_\_\_\_\_

County: Pearl River  
 Permit #: \_\_\_\_\_  
 Driller: Travis Boone  
 Date drilling completed: 5-21-06

State Law requires that this report be prepared by the driller in detail and filed with the Department within 30 days of completion of drilling of the well.

Well Owner Information	Well Location
Owner Name: <u>Kenny Small</u>	Latitude: _____ Longitude: _____
Mailing Address: <u>1164 T Rd Lumberton</u>	Method of Lat/Long (circle one): Conventional Survey,
<u>MS</u>	USGS quad, Hand-held GPS, Survey-grade GPS
<u>39455</u>	<u>1/4</u> <u>4</u> Sec <u>4</u> Twn <u>25</u> Rng <u>14W</u>
City State Zip Code	Distance Direction Nearest Town
Telephone No. ( ) _____	<u>7</u> Miles <u>SE</u> of <u>Lumberton</u>

#### Well Data

Purpose of Well (circle one) Home Industrial Public Supply Irrigation Fish Culture Other: \_\_\_\_\_

Date well drilling started: 5-21-06 Date well drilling completed: 5-21-06

If flowing, method of flow regulation: Valve \_\_\_\_\_ Other (describe) \_\_\_\_\_

Static Water Level: 90 feet above or below (circle one) land surface Date measured: 5-21-06

Method of Measurement (circle one) steel tape electric tape air line other: StringLine

Hole depth: \_\_\_\_\_ Well depth: 185 Well grouted to a depth of 10 feet

Type of grout (circle one): Cement Bentonite Mix

Casing length: 1165 feet Casing diameter: 4 inches Type of casing: sch 40

Screen length: 20 feet Screen diameter: 4 inches Type of screen: sch 40

Screen slot size: 8 inches Setting depth: From 1165 feet to 185 feet

Type of completion (circle all applicable): Gravel packed Underreamed Telescoped Open hole Natural Development

Other (describe): \_\_\_\_\_

Top of lap pipe or reduction in casing: \_\_\_\_\_ feet. If telescoped or more than one screen, describe on back of page

Logs run (circle all applicable): No log run Electric Gamma Ray Density Sonic Neutron Other: \_\_\_\_\_

Name of organization running log(s): \_\_\_\_\_

I certify that the well was drilled, constructed, and completed in accordance with all applicable requirements of the Mississippi Department of Environmental Quality and/or the Mississippi Department of Health regulations and state laws.

Travis Boone 0-514  
 Print Name of Water Well Contractor and License No.

Travis Boone  
 Signature of Water Well Contractor

RECEIVED  
 JUN 21 2006  
 BY: OLWR

FEB-23-2002 06:21A FROM:


TO: 16013600535

P:1

H-44

If well telescopes please sketch below and show depths.

Ground Level

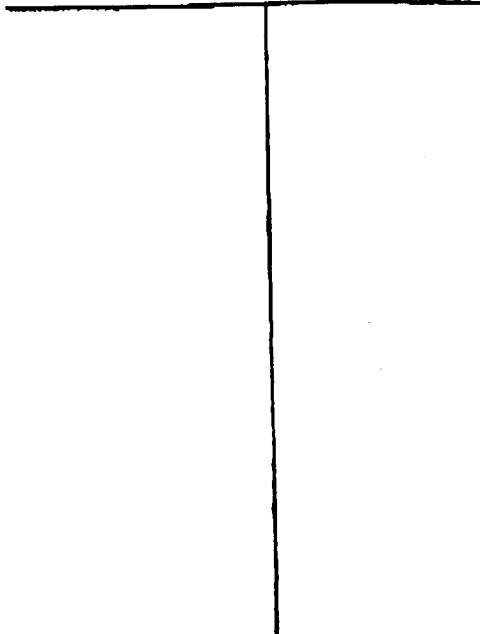

Description of Formations Encountered

From To

Description of Formations Encountered	From	To
Clay sand	0	20
Clay sand	20	75
Clay sand	75	130
	130	185

If more than one screen, show location of each on sketch

Sketch the property layout and include the following: 1) the well location; 2) any permanent structures on the property that may aid in locating the well; 3) any roads, power lines, or other items that may aid in locating the property and the well; 4) indicate direction.

Landowner Name: Kenny Small

[Signature]  
Signature of Well Contractor

RECEIVED  
JUN 21 2006  
BY: OLWR

### STATE WELL REPORT

#### Part 2

**Pump Installer's Completion Report**  
 Mississippi Department of Environmental Quality  
 Office of Land and Water Resources  
 P.O. Box 10651  
 Jackson, MS 39289-0691  
 (601)961-5210  
 (601)354-6938 (fax)

County: Pearl River  
 Permit #: \_\_\_\_\_  
 Driller: Travis Boone  
 Date completed: 5-21-06

**For Office Use Only:**  
 Aquifer: \_\_\_\_\_  
 Well #: H-44  
 Elevation: \_\_\_\_\_

This report should be prepared by the pump installer in detail and filed with the Department within 30 days of the installation of pump.

Well Owner Information	Well Location
Owner Name: <u>Kenny Small</u>	Latitude: _____ Longitude: _____
Mailing Address: <u>164 T Rd</u>	Method of Lat/Long (circle one): <u>Conventional Survey</u>
<u>Lumberton MS</u>	USGS quad, Hand-held GPS, Survey-grade GPS
<u>39455</u>	<u>1/4 1/4 Sec 4 Twn 25 Rng 14W</u>
City State Zip Code	Distance Direction Nearest Town
Telephone No. ( ) _____	<u>7 Miles SE of Lumberton</u>

Pump Type Circle one	Power Type Circle one
Air Lift Jet <input checked="" type="radio"/> <u>Submersible</u>	Diesel Engine Gasoline Engine Natural Gas
Bucket Piston Turbine	<input checked="" type="radio"/> <u>Electric Motor</u> Hand Tractor PTO
Centrifugal Rotary Flowing Well	Windmill Other (specify): _____
Other (specify): _____	Horse Power Rating of Motor: <u>2</u>
Date Pump Installed: <u>5-21-06</u>	Setting Depth: <u>140</u> feet
Rated Pump Capacity: <u>25</u> Gallons Per Minute	Number of Stages: _____

Pump Test Data	Method of Measuring Water Level Circle one
Date Well Tested: <u>5-21-06</u>	Air Line Electric Measuring Line Steel Tape
Static Water Level (A): <u>90</u> Feet Below Land Surface	Other (specify): <u>string line</u>
Pumping Water Level (B): _____ Feet Below Land Surface	For flowing well, measured shut in head: _____ feet
Drawdown ((B) - (A)): _____ Feet Below Land Surface	Well yielded _____ GPM with a drawdown of _____ feet after _____ hours of pumping
Test Pumping Rate: <u>35 DF</u> Gallons Per Minute	
Duration of Pump Test (minimum 4 hours): _____ hours	

I HEREBY CERTIFY that the above statements are true to the best of my knowledge.

Travis Boone  
 Print Name of Pump Installer and License No. (if applicable)

Travis Boone  
 Signature of Pump Installer

RECEIVED  
 JUN 21 2006  
 BY: OLWR