

# State Well Report

## Part I

Mississippi Department of Environmental Quality  
 Office of Land and Water Resources  
 P.O. Box 10631  
 Jackson, MS 39289-0631  
 (601)961-5210  
 (601)354-6938 (fax)

For Office Use Only:

Aquifer: \_\_\_\_\_  
 Well #: H-53  
 L. S. Elevation: \_\_\_\_\_  
 B-log #: \_\_\_\_\_

County: Pearl River  
 Permit #: \_\_\_\_\_  
 Driller: AL HARRINGTON  
 Date drilling completed: 11/10/08

State Law requires that this report be prepared by the driller in detail and filed with the Department within 30 days of completion of drilling of the well.

Well Owner Information	Well Location
Owner Name: <u>Heath Gomez</u>	Latitude: <u>30° 54' 28"</u> Longitude: <u>-89° 22' 58"</u>
Mailing Address: <u>Otha Davis Rd</u>	Method of Lat/Long (circle one): Conventional Survey, <u>USGS quad</u> <u>Hand-held GPS</u> , Survey-grade GPS
<u>Lumberton MS 39453</u>	<u>NE 1/4 NW 1/4 Sec 3 Twn 25 Rng 14W</u>
City State Zip Code	Distance Direction Nearest Town
Telephone No. ( ) _____	<u>4</u> Miles <u>SW</u> of <u>Hillard</u>

**Well Data**

Purpose of Well (circle one) Home Industrial Public Supply Irrigation Fish Culture Other: \_\_\_\_\_

Date well drilling started: 11/10/08 Date well drilling completed: 11/10/08

If flowing, method of flow regulation: Valve \_\_\_\_\_ Other (describe) \_\_\_\_\_

Static Water Level: 54' feet above or below (circle one) land surface Date measured: 11/10/08

Method of Measurement (circle one) steel tape electric tape air line other: \_\_\_\_\_

Hole depth: 120' Well depth: 116' Well grouted to a depth of 10' feet

Type of grout (circle one): Cement Bentonite Mix

Casing length: 106' feet Casing diameter: 4" inches Type of casing: PVC

Screen length: 10' feet Screen diameter: 4" inches Type of screen: PVC

Screen slot size: .008 inches Setting depth: From 106' feet to 116' feet

Type of completion (circle all applicable): Gravel packed Underreamed Telescoped Open hole Natural Development

Other (describe): \_\_\_\_\_

Top of lap pipe or reduction in casing: \_\_\_\_\_ feet. If telescoped or more than one screen, describe on back of page

Logs run (circle all applicable): No log run Electric Gamma Ray Density Sonic Neutron Other: \_\_\_\_\_

Name of organization running log(s): \_\_\_\_\_

I certify that the well was drilled, constructed, and completed in accordance with all applicable requirements of the Mississippi Department of Environmental Quality and/or the Mississippi Department of Health regulations and state laws.

AL HARRINGTON #0-564  
 Print Name of Water Well Contractor and License No.


AL Harrington  
 Signature of Water Well Contractor

RECEIVED  
 DEC 04 2008  
 BY: OLWR

H-53

If well telescopes please sketch below and show depths.

Ground Level

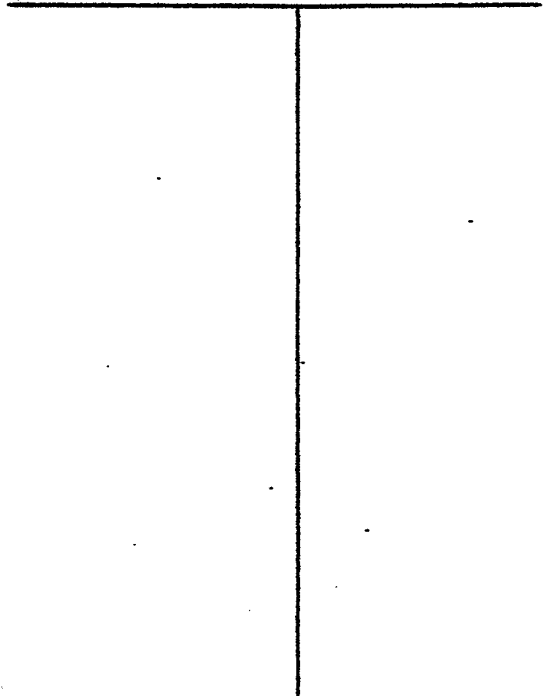

Description of Formations Encountered	From	To
Sandy loam	0	1
clay	1	5'
yellow sand	5'	30'
orange sand	30'	80'
Coarse sand + gravel	80'	120'

If more than one screen, show location of each on sketch

Sketch the property layout and include the following: 1) the well location; 2) any permanent structures on the property that may aid in locating the well; 3) any roads, power lines, or other items that may aid in locating the property and the well; 4) indicate direction.

The sketch shows a property layout with the following features:
 

- A diagonal line labeled 'DRIVE' on the left side.
- A small circle labeled 'well' located between the driveway and the house.
- A rectangular box labeled 'HOME' representing the house.
- A vertical line on the right side labeled 'OTHO PANIG RD'.
- An arrow pointing upwards with the letter 'N' next to it, indicating North.

Landowner Name: Heath Gomes

Al Harrington  
Signature of Water Well Contractor

RECEIVED  
DEC 04 2008  
BY: OLWR

# STATE WELL REPORT

## Part 2

**Pump Installer's Completion Report**  
 Mississippi Department of Environmental Quality  
 Office of Land and Water Resources  
 P.O. Box 10631  
 Jackson, MS 39289-0631  
 (601)961-5210  
 (601)354-6938 (fax)

For Office Use Only:

Aquifer: \_\_\_\_\_

Well #: H-53

Elevation: \_\_\_\_\_

County: Pearl River

Permit #: \_\_\_\_\_

Driller: AL HARRINGTON

Date completed: 11/10/08

This report should be prepared by the pump installer in detail and filed with the Department within 30 days of the installation of pump.

Well Owner Information	Well Location
Owner Name: <u>Heath Gamez</u>	Latitude: <u>30°54'28"</u> Longitude: <u>-89°22'58"</u>
Mailing Address: _____ <u>Otha Davis Rd</u> <u>Lumberton MS 39455</u> City State Zip Code	Method of Lat/Long (circle one): Conventional Survey, USGS quad, Hand-held GPS, Survey-grade GPS <u>NE 1/4 NW 1/4 Sec 3 Twn 25 Rng 14W</u>
Telephone No. ( ) _____	Distance Direction Nearest Town <u>1/4</u> Miles <u>SW</u> of <u>Hillsdale</u>

Pump Type Circle one	Power Type Circle one
Air Lift Jet <input type="radio"/> <input checked="" type="radio"/> <u>Submersible</u>	Diesel Engine Gasoline Engine Natural Gas
Bucket Piston Turbine	<input checked="" type="radio"/> <u>Electric Motor</u> Hand Tractor PTO
Centrifugal Rotary Flowing Well	Windmill Other (specify): _____
Other (specify): _____	Horse Power Rating of Motor: <u>1 HP</u>
Date Pump Installed: <u>11/10/08</u>	Setting Depth: <u>Set at 80'</u> feet
Rated Pump Capacity: <u>20</u> Gallons Per Minute	Number of Stages: <u>20' 6PM sub</u>

Pump Test Data	Method of Measuring Water Level Circle one
Date Well Tested: <u>11/10/08</u>	Air Line Electric Measuring Line <input checked="" type="radio"/> <u>Steel Tape</u>
Static Water Level (A): <u>54'</u> Feet Below Land Surface	Other (specify): _____
Pumping Water Level (B): <u>780'</u> Feet Below Land Surface	For flowing well, measured shut in head: _____ feet
Drawdown [(B) - (A)]: _____ Feet Below Land Surface	Well yielded _____ GPM with a drawdown of _____ feet after _____ hours of pumping
Test Pumping Rate: _____ Gallons Per Minute	
Duration of Pump Test (minimum 4 hours): _____ hours	

I HEREBY CERTIFY that the above statements are true to the best of my knowledge.

AL HARRINGTON #0-564 Al Harrington  
 Print Name of Pump Installer and License No. (if applicable) Signature of Pump Installer

RECEIVED  
 DEC 04 2008  
 BY: OLWR