

Part 2 never received 4/13

# State Well Report

## Part I

Mississippi Department of Environmental Quality  
Office of Land and Water Resources  
P.O. Box 10631  
Jackson, MS 39289-0631  
(601)961-5210  
(601)354-6938 (fax)

For Office Use Only:

Aquifer: H57  
Well #: \_\_\_\_\_  
L. S. Elevation: \_\_\_\_\_  
E-log #: \_\_\_\_\_

County: Pearl River  
Permit #: \_\_\_\_\_  
Driller: AL HARRINGTON  
Date drilling completed: 3/27/11

State Law requires that this report be prepared by the driller in detail and filed with the Department within 30 days of completion of drilling of the well.

Well Owner Information	Well Location
Owner Name: <u>Oak Glen Farms</u>	Latitude: <u>30° 52' .31"</u> Longitude: <u>-89° 22' .49"</u>
Mailing Address: <u>County Farm Rd.</u> <del>_____</del> <u>Lumberton MS 39455</u>	Method of Lat/Long (circle one): Conventional Survey, USGS quad, <u>Hand-held GPS</u> , Survey-grade GPS <input checked="" type="checkbox"/>
City: _____ State: _____ Zip Code: _____	<u>9W 1/4 NE 1/4 Sec 15 Twn 29 Rng 14 W</u>
Telephone No. ( ) _____	Distance: <u>10</u> Miles Direction: <u>SE</u> of Nearest Town: <u>Lumberton</u>

**Well Data**

Purpose of Well (circle one) Home Industrial Public Supply Irrigation Fish Culture Other: \_\_\_\_\_

Date well drilling started: 3/27/11 Date well drilling completed: 3/27/11

If flowing, method of flow regulation: Valve \_\_\_\_\_ Other (describe) \_\_\_\_\_

Static Water Level: 42' feet above or below (circle one) land surface Date measured: 3/27/11

Method of Measurement (circle one) steel tape electric tape air line other: \_\_\_\_\_

Hole depth: 140' Well depth: 140' Well grouted to a depth of 10' feet

Type of grout (circle one): Cement Bentonite Mix

Casing length: 130' feet Casing diameter: 4" inches Type of casing: PVC

Screen length: 10' feet Screen diameter: 4" inches Type of screen: PVC

Screen slot size: 1008 inches Setting depth: From 130' feet to 140' feet

Type of completion (circle all applicable): Gravel packed Underreamed Telescoped Open hole Natural Development

Other (describe): \_\_\_\_\_

Top of lap pipe or reduction in casing: \_\_\_\_\_ feet. If telescoped or more than one screen, describe on back of page

Logs run (circle all applicable): No log run Electric Gamma Ray Density Sonic Neutron Other: \_\_\_\_\_

Name of organization running log(s): \_\_\_\_\_


I certify that the well was drilled, constructed, and completed in accordance with all applicable requirements of the Mississippi Department of Environmental Quality and/or the Mississippi Department of Health regulations and state laws.

AL HARRINGTON #0-564 \_\_\_\_\_  
Print Name of Water Well Contractor and License No. Signature of Water Well Contractor

NO - Pump Not Drilled For  
Customer supplied wind mill

If well telescopes please sketch below and show depths.

Ground Level

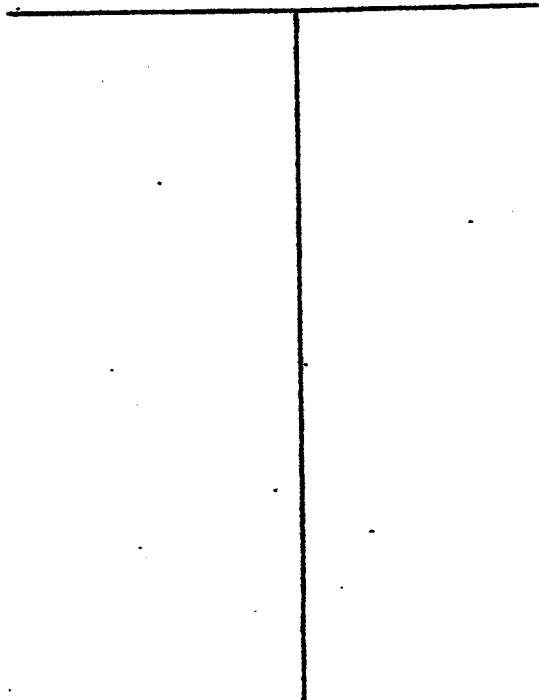

Description of Formations Encountered	From	To
<del>Red Rock</del> Clay	0	5'
red white mottling clay	5'	11'
white clay	11'	118'
fine sand sand	118'	120'
med sand	120'	140'

If more than one screen, show location of each on sketch

Sketch the property layout and include the following: 1) the well location; 2) any permanent structures on the property that may aid in locating the well; 3) any roads, power lines, or other items that may aid in locating the property and the well; 4) indicate direction.

Landowner Name: Oak Den Farms

Al Harringer  
Signature of Water Well Contractor

NO, Pump set, Drilled for Customer supplied windmill.