

Pearl R.
 H 200
 2/3/78

MISSISSIPPI
 BOARD OF WATER COMMISSIONERS
 416 North State Street
 Jackson, Mississippi 39201

WATER WELL DRILLERS LOG

2-2 1978 Danell Andersen Pearl River
 date well completed firm name county well located


LANDOWNER:	description of formations encountered	from	to
<u>Denise Wayne Pedaug</u>			
(mailing address)	<u>Red Clay</u>	<u>3</u>	<u>13</u>
WELL LOCATION:	<u>Course Sand</u>	<u>13</u>	<u>36</u>
sec. <u>9</u> T. <u>2</u> N. <u>S</u> R. <u>14</u> E. <u>W</u>			
<u>9</u> miles <u>N.E.</u> of <u>Pearl River</u>			
(distance) (direction) (nearest town)			
WELL PURPOSE: <u>HOME</u> (home, irrigation, municipal, industrial)			
WELL COMPLETION DATA:			
(1) diameter (inches) <u>2"</u>			
(2) total depth (feet) <u>46'</u>			
(3) static water level (feet) <u>31'</u> below top of ground.			
(4) casing <u>Plastic</u> , <u>41'</u> (material) (depth)			
(size) If telescope see back.			
(5) screen <u>5"</u> , <u>41'</u> (length) (depth to top)			
<u>2"</u> , <u>Plastic</u> (size) (material)			
(6) pump <u>1</u> , <u>9</u> (HP) (yield gpm)			
<u>Elect</u> (type power)			
(7) electric log <u>no</u> (yes or no)			
(organization running log)			
(8) how well bottom plugged <u>Capped</u>			
DRILLERS REMARKS:			

RECEIVED
 MAR - 7 1978

MISS. BD. OF WATER COMM

If well telescopes please sketch and show depths.

GROUND LEVEL

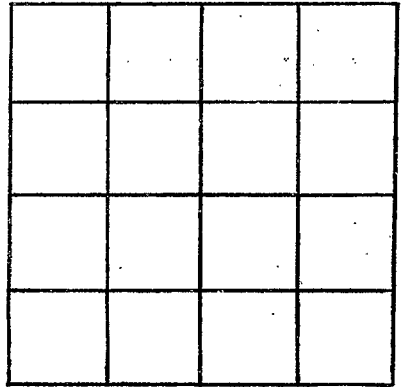

SECTION _____

Please indicate well location X.

ADDITIONAL INFORMATION

If more than one screen,
show locations of each on sketch.