

PEARL RIVER  
 H 2001  
 -78

MISSISSIPPI  
 BOARD OF WATER COMMISSIONERS  
 416 North State Street  
 Jackson, Mississippi 39201

WATER WELL DRILLERS LOG

1978 Panel Anderson Pearl River

date well completed

firm name

county well located

LANDOWNER:

George Acosta

(mailing address)

WELL LOCATION:

sec. 27 T 2 N R 14 E W  
 S  
 1.0 miles E of Rosedale  
 (distance) (direction) (nearest town)

WELL PURPOSE: HOME  
 (home, irrigation, municipal, industrial)

WELL COMPLETION DATA:

- (1) diameter (inches) 2"
- (2) total depth (feet) 78
- (3) static water level (feet) 58 below top of ground.
- (4) casing Plastic 73' (material) (depth)
- (size) if telescope see back.
- (5) screen 5' 73' (length) (depth to top)  
 2" Plastic (size) (material)
- (6) pump 1 10 (HP) (yield gpm)  
 Elect (type power)
- (7) electric log No (yes or no)

(organization running log)


(8) how well bottom plugged Capped

DRILLERS REMARKS:

description of formations encountered

from to

Top Soil	0	2
Clay	2	55
Fine Sand	55	70
Coarse Sand	70	78

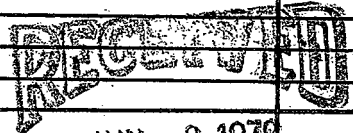

JUN - 2 1978

MISS. BD. OF WATER COMMISSIONERS

If well telescopes please sketch and show depths.

GROUND LEVEL


SECTION \_\_\_\_\_

Please indicate well location X.

ADDITIONAL INFORMATION

If more than one screen,  
show locations of each on sketch.