

PEARL RIVER

H 2002

5-29-78

MISSISSIPPI BOARD OF WATER COMMISSIONERS 416 North State Street Jackson, Mississippi 39201

WATER WELL DRILLERS LOG

5-29-78 date well completed

1978 Pearl River firm name

Pearl River county well located

LANDOWNER:

Mary Shaw

(mailing address)

WELL LOCATION:

sec 21 T 2 N R 14 E S 9 miles E of Poplarville

WELL PURPOSE: HOME (home, irrigation, municipal, industrial)

WELL COMPLETION DATA:

- (1) diameter (inches) 2"
(2) total depth (feet) 125'
(3) static water level (feet) 70' below top of ground
(4) casing Plastic, 120' (material) (depth)
(5) screen 5' 120' (length) (depth to top)
2" Plastic (size) (material)
(6) pump 1 8 (HP) (yield gpm)
E lect (type power)
(7) electric log no (yes or no)

(organization running log)


(8) how well bottom plugged Capped

DRILLERS REMARKS:

description of formations encountered

from to

Top Soil 0 3
Red Sand 3 14
white clay 14 112
Coarse Sand 112 125

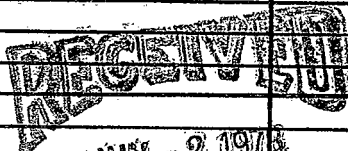

JUN - 2 1978

MISS. BD. OF WATER COMMISSIONERS

If well telescopes please sketch and show depths.

GROUND LEVEL

SECTION _____

Please indicate well location X.

ADDITIONAL INFORMATION

If more than one screen, show locations of each on sketch.