

PEARL RIVER
H 2004
10-6-78

**MISSISSIPPI
BOARD OF WATER COMMISSIONERS**
416 North State Street
Jackson, Mississippi 39201

WATER WELL DRILLERS LOG

October 6, 1978 Dixie Water Well & Pump, Inc. Pearl River
 date well completed firm name county well located

LANDOWNER: Mrs. Bessie Wilson
Pt. 2 - Box 295 AA
Poplarville, Miss. 39470
 (mailing address)

description of formations encountered	feet	fract.
<u>Red Sand</u>	<u>0</u>	<u>17'</u>
<u>yellow sand</u>	<u>17'</u>	<u>50'</u>

WELL LOCATION:
 sec. 30 T. 2 N. R. 14 E.
6 miles East of Poplarville
 (distance) (direction) (nearest town)

WELL PURPOSE: Home
 (home, irrigation, municipal, industrial)

WELL COMPLETION DATA:

(1) diameter (inches) 2"

(2) total depth (feet) 50'

(3) static water level (feet) 28' Below Above
 top of ground.

(4) casing P.V.C. 40'
 (material) (depth)

2"
 (size) if telescope see back.

(5) screen 10' 40'
 (length) (depth to top)

2" P.V.C.
 (size) (material)

(6) pump 1 8
 (HP) (yield gpm)

Electric
 (type power)

(7) electric log No
 (yes or no)

(organization running log)


(8) how well bottom plugged
Sand Shark

DRILLERS REMARKS:

RECEIVED
 OCT 27 1978
 MISS. BD. OF WATER COMM

If well telescopes please sketch and show depths.

GROUND LEVEL

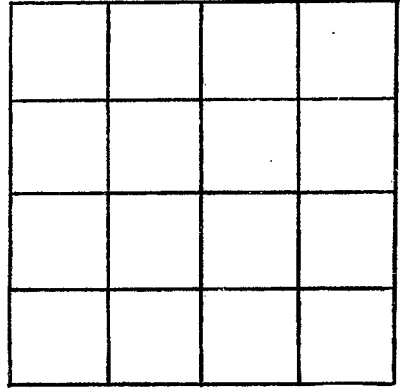

SECTION _____

Please indicate well location X.

ADDITIONAL INFORMATION

If more than one screen,
show locations of each on sketch.