

PEARL RIVER

H 2005

5-17-79

MISSISSIPPI  
 BOARD OF WATER COMMISSIONERS  
 416 North State Street  
 Jackson, Mississippi 39201

WATER WELL DRILLERS LOG

5-17

date well completed

1979 *Samuel Anderson*

firm name

*Pearl River*

county well located

LANDOWNER:

*Oscar Lee*

description of formations encountered

*Topsoil*

from

to

0

1

(mailing address)

*Clay*

1

80

WELL LOCATION:

sec. *29* T. *2* N. R. *14* W.

*7* miles *E* of *Poplarville*  
(distance) (direction) (nearest town)

*7 Fine Sand*

80

114

WELL PURPOSE: *HOME*  
(home, irrigation, municipal, industrial)

WELL COMPLETION DATA:

- (1) diameter (inches) *2"*
- (2) total depth (feet) *114'*
- (3) static water level (feet) *84* below above top of ground.
- (4) casing *Plastic 109'*  
(material) (depth)

(size) if telescope see back.

- (5) screen *5'*, *109'*  
(length) (depth to top)
- 2"*, *Plastic*  
(size) (material)

- (6) pump *1*, *4*  
(HP) (yield gpm)
- Coast*  
(type power)

- (7) electric log *no*  
(yes or no)

(organization running log)

- (8) how well bottom plugged *Capred*

DRILLERS REMARKS:


Miss. Board of Water Comm.

JUN - 8 1979

RECEIVED

If well telescopes please sketch and show depths.

GROUND LEVEL

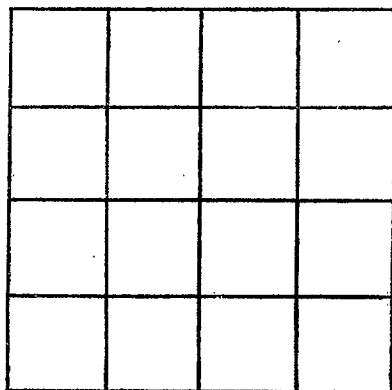

SECTION \_\_\_\_\_

Please indicate well location X.

ADDITIONAL INFORMATION

If more than one screen, show locations of each on sketch.