

Pearl River
H 2000
2-72-79

MISSISSIPPI
 BOARD OF WATER COMMISSIONERS
 416 North State Street
 Jackson, Mississippi 39201

WATER WELL DRILLERS LOG

2/22 1979 Bud Penton Pearl River
 date well completed firm name county well located

LANDOWNER: Donald B. Berry
R.T. 2 Dacyne
Miss
 (mailing address)

description of formations encountered	from	to
<u>Red shal</u>	<u>0</u>	<u>22</u>
<u>White sand</u>	<u>22</u>	<u>65</u>
<u>Blue shale</u>	<u>65</u>	<u>201</u>
<u>Blue sand</u>	<u>201</u>	<u>240</u>

WELL LOCATION:
30 ~~20~~ 20 T SE N 14 R W E
6 miles East of plaque
 (distance) (direction) (nearest town)

WELL PURPOSE: home
 (home, irrigation, municipal, industrial)

- WELL COMPLETION DATA:
- (1) diameter (inches) 4"
 - (2) total depth (feet) 240
 - (3) static water level (feet) 28 below above top of ground.
 - (4) casing PVC, 240,
 (material) (depth)
 (size) if telescope see back.
 - (5) screen 4 x 10, 230
 (length) (depth to top)
12, PVC
 (size) (material)
 - (6) pump 1 16.5-0
 (HP) (yield gpm)
elect.
 (type power)
 - (7) electric log no
 (yes or no)

(organization running log)
 (8) how well bottom plugged shard

DRILLERS REMARKS:


Miss. Board of Water Comm.

APR 30 1979

RECEIVED

If well telescopes please sketch and show depths.

GROUND LEVEL

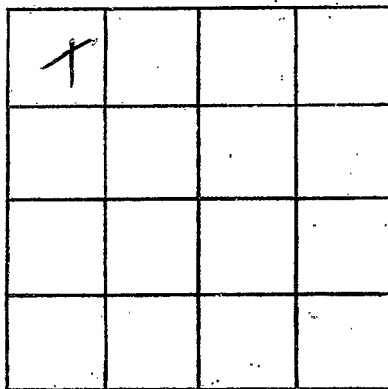

SECTION _____

Please indicate well location X.

ADDITIONAL INFORMATION

If more than one screen, show locations of each on sketch.