

Pearl River  
H 2007  
4/31/79

MISSISSIPPI  
 BOARD OF WATER COMMISSIONERS  
 416 North State Street  
 Jackson, Mississippi 39201

WATER WELL DRILLERS LOG

4/31 1979 Paul Patton Pearl River  
 date well completed firm name county well located

LANDOWNER: Dawson Adams  
RT. 2, Box 130  
Osprey Miss.  
 (mailing address)

description of formations encountered	from	to
<u>Red shale</u>	<u>0</u>	<u>96</u>
<u>Blue shale</u>	<u>96</u>	<u>275</u>
<u>Blue sand</u>	<u>275</u>	<u>290</u>

WELL LOCATION:  
 sec. 6 T. 3 N. R. 14 E.  
B miles N of Osprey  
 (distance) (direction) (nearest town)

WELL PURPOSE: home  
 (home, irrigation, municipal, industrial)

- WELL COMPLETION DATA:
- (1) diameter (inches) 4"
  - (2) total depth (feet) 290
  - (3) static water level (feet) 1.35 below above top of ground.
  - (4) casing PVC, 290,  
 (material) (depth)  
 (size) If telescope see back.
  - (5) screen 4x10, 280  
 (length) (depth to top)  
12, PVC  
 (size) (material)
  - (6) pump 1, 650  
 (HP) (yield gpm)  
 (type power)
  - (7) electric log no  
 (yes or no)  
 (organization running log)
  - (8) how well bottom plugged plug

DRILLERS REMARKS:


Miss. Board of Water Comm.

JUL 30 1979

RECEIVED

If well telescopes please sketch and show depths.

GROUND LEVEL

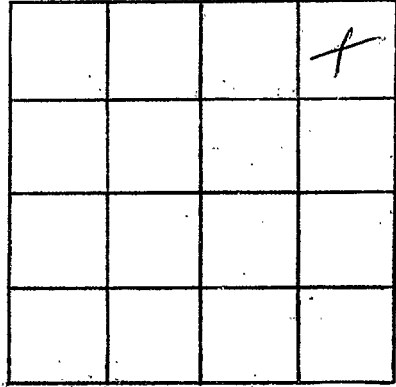

SECTION \_\_\_\_\_

Please indicate well location X.

ADDITIONAL INFORMATION

If more than one screen,  
show locations of each on sketch.