

Pearl River
H 2008
8-9-79
8-9

MISSISSIPPI
BOARD OF WATER COMMISSIONERS
416 North State Street
Jackson, Mississippi 39201

WATER WELL DRILLERS LOG

1979 Bennell Anderson Pearl River
date well completed firm name county well located

LANDOWNER:	description of formations encountered	from	to
<u>Bonnie Ladner</u>	<u>Top Soil</u>	<u>0</u>	<u>3</u>
(mailing address)	<u>Sandy Clay</u>	<u>3</u>	<u>25</u>
WELL LOCATION: sec. <u>14</u> T <u>2</u> N R <u>14</u> E S W <u>11</u> miles <u>E</u> of <u>Poplarville</u> (distance) (direction) (nearest town)	<u>Course Sand</u>	<u>25</u>	<u>56</u>
WELL PURPOSE: <u>HOME</u> (home, irrigation, municipal, industrial)			
WELL COMPLETION DATA: (1) diameter (inches) <u>2"</u> (2) total depth (feet) <u>56'</u> (3) static water level (feet) <u>26'</u> below above top of ground. (4) casing <u>Plastic</u> , <u>57'</u> (material) (depth) <u> </u> (size) If telescope see back. (5) screen <u>5'</u> , <u>57'</u> (length) (depth to top) <u>2"</u> , <u>Plastic</u> (size) (material) (6) pump <u>1</u> , <u>11</u> (HP) (yield gpm) <u>Elect</u> (type power) (7) electric log <u>no</u> (yes or no) <u> </u> (organization running log) (8) how well bottom plugged <u>Plugged</u>			

DRILLERS REMARKS:


Miss. Board of Water Comm.

SEP 11 1979

RECEIVED

If well telescopes please sketch and show depths.

GROUND LEVEL

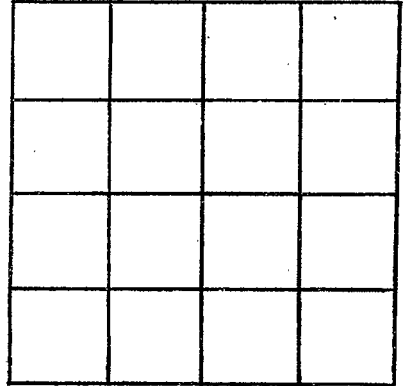

SECTION _____

Please indicate well location X.

ADDITIONAL INFORMATION

If more than one screen,
show locations of each on sketch.