

Pearl River
H 2009
5-13-80

MISSISSIPPI
 BOARD OF WATER COMMISSIONERS
 416 North State Street
 Jackson, Mississippi 39201

WATER WELL DRILLERS LOG

5-13 1980 Arnold Anderson Pearl River
 date well completed firm name county well located

LANDOWNER:	description of formations encountered	from	to
<u>Jack White</u>			
(mailing address)	<u>Sandy Clay</u>	<u>2</u>	<u>75</u>
WELL LOCATION:	<u>Clay</u>	<u>75</u>	<u>190</u>
sec. <u>36</u> T. <u>2</u> N. R. <u>14</u> S	<u>Fine Sand</u>	<u>190</u>	<u>240</u>
<u>7</u> miles <u>N</u> of <u>Silver Run</u>	<u>Course Sand</u>	<u>240</u>	<u>254</u>
(distance) (direction) (nearest town)			
WELL PURPOSE: <u>HOME</u> (home, irrigation, municipal, industrial)			
WELL COMPLETION DATA:			
(1) diameter (inches) <u>2"</u>			
(2) total depth (feet) <u>254'</u>			
(3) static water level (feet) <u>36</u> below top of ground.			
(4) casing <u>Plastic</u> , <u>249'</u> (material) (depth)			
(size) If telescope see back.			
(5) screen <u>5"</u> , <u>249'</u> (length) (depth to top)			
<u>2"</u> <u>Plastic</u> (size) (material)			
(6) pump <u>1</u> <u>15'</u> (HP) (yield gpm)			
<u>Elect</u> (type power)			
(7) electric log <u>no</u> (yes or no)			
(organization running log)			
(8) how well bottom plugged <u>cased</u>			
DRILLERS REMARKS:			


DEPT. OF NATURAL RESOURCES
 BUREAU OF LAND & WATER RESOURCES

JUN 4 - 1980

RECEIVED

If well telescopes please sketch and show depths.

GROUND LEVEL

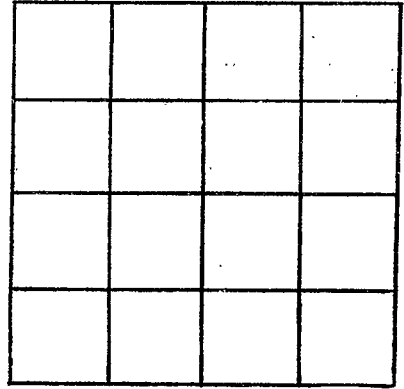

SECTION _____

Please indicate well location X.

ADDITIONAL INFORMATION

If more than one screen,
show locations of each on sketch.