


PEARL RIVER
H 2010
3/17/81

MISSISSIPPI
BOARD OF WATER COMMISSIONERS
416 North State Street
Jackson, Mississippi 39201

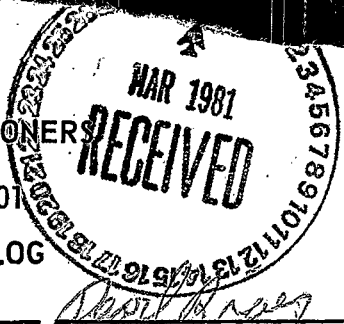

WATER WELL DRILLERS LOG

date well completed 3/17/81 31 Bud Denton firm name
Water Well Service county well located Pearl River

LANDOWNER: NO. Spiers
PO Box 562
Poplarnell Miss.
(mailing address)

description of formations encountered	from	to
<u>Red Shell</u>	<u>0</u>	<u>60</u>
<u>White Shell</u>	<u>60</u>	<u>175</u>
<u>White Sandstone</u>	<u>175</u>	<u>200</u>
<u>White Shell</u>	<u>200</u>	<u>275</u>
<u>White Sand</u>	<u>275</u>	<u>295</u>

WELL LOCATION:
sec. 20 T. 2 N. R. 14 E
8 miles East of Poplarnell
(distance) (direction) (nearest town)

WELL PURPOSE: Home
(home, irrigation, municipal, industrial)

- WELL COMPLETION DATA:
- (1) diameter (inches) 4"
 - (2) total depth (feet) 295
 - (3) static water level (feet) 135 below above top of ground.
 - (4) casing PVC, 285,
(material) (depth)
(size) if telescope see back.
 - (5) screen 4x10, 285
(length) (depth to top)
12, PVC
(size) (material)
 - (6) pump 3/4, 450
(HP) (yield gpm) 1/2"
Elect.
(type power)
 - (7) electric log no
(yes or no)

(organization running log)
(8) how well bottom plugged shut

DRILLERS REMARKS:

If well-telescopes please sketch and show depths.

GROUND LEVEL

			X

SECTION _____

Please indicate well location X.

ADDITIONAL INFORMATION

If more than one screen,
show locations of each on sketch.