

Paul River  
H2011

MISSISSIPPI  
 BOARD OF WATER COMMISSIONERS  
 416 North State Street  
 Jackson, Mississippi 39201

WATER WELL DRILLERS LOG

March 16 1982 Parnee Anderson Paul River  
 date well completed firm name county well located

LANDOWNER	Description of formations encountered	from	to
<u>Hudson's Construction</u>	<u>Top Soil</u>	<u>0</u>	<u>1</u>
<u>O.O. Boy 146</u>	<u>Clay</u>	<u>1</u>	<u>19</u>
<u>Paplarville, Ms</u> (mailing address)	<u>Sand</u>	<u>19</u>	<u>30</u>
	<u>Clay</u>	<u>30</u>	<u>38</u>
	<u>Sand fine</u>	<u>38</u>	<u>42</u>
	<u>Sand coarse</u>	<u>42</u>	<u>58</u>
	<u>Sand coarse + gravel</u>	<u>58</u>	<u>63</u>
<b>WELL LOCATION:</b>			
sec <u>33</u> T <u>2</u> S R <u>14</u> W			
<u>9</u> miles <u>E</u> of <u>Paplarville</u>			
(distance) (direction) (nearest town)			
<b>WELL PURPOSE:</b> <u>none</u> (home, irrigation, municipal, industrial)			
<b>WELL COMPLETION DATA:</b>			
(1) diameter (inches) <u>2"</u>			
(2) total depth (feet) <u>63'</u>			
(3) static water level (feet) <u>57'</u> below top of ground.			
(4) casing <u>PVC</u> (material) (depth)			
(size) If telescope see back.			
(5) screen <u>5'</u> <u>58'</u> (length) (depth to top)			
<u>2"</u> <u>PVC</u> (size) (material)			
(6) pump <u>1</u> <u>12</u> (HP) (yield gpm)			
<u>Electric</u> (type power)			
(7) electric log <u>NO</u> (yes or no)			
(organization running log)			
(8) how well bottom plugged <u>Capped</u>			
<b>DRILLERS REMARKS:</b>			


DEPT. OF NATURAL RESOURCES  
 BUREAU OF LAND & WATER RESOURCES

JUN - 9 1982

RECEIVED

If well telescopes please sketch and show depths.

GROUND LEVEL

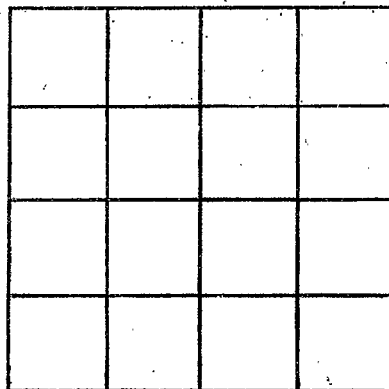

SECTION \_\_\_\_\_

Please indicate well location X.

ADDITIONAL INFORMATION

If more than one screen,  
show locations of each on sketch.