

Paul River  
H 2012

MISSISSIPPI  
 BOARD OF WATER COMMISSIONERS  
 416 North State Street  
 Jackson, Mississippi 39201

WATER WELL DRILLERS LOG

Sept 13 1982 Larnee Anderson Pearl River  
 date well completed firm name county well located

LANDOWNER: Cheryl R. Lee

description of formations encountered

from to

Cat  
Lumberton, Ms  
 (mailing address)

|          |    |    |
|----------|----|----|
| top soil | 0  | 2  |
| clay     | 2  | 17 |
| sand     | 17 | 28 |
| clay     | 28 | 32 |
| sands    | 32 | 50 |

WELL LOCATION:

sec 21 T 2 R 14  
 S W  
9 miles E of Poplarville  
 (distance) (direction) (nearest town)

WELL PURPOSE: Home  
 (home, irrigation, municipal, industrial)

WELL COMPLETION DATA:

- (1) diameter (inches) 2"
- (2) total depth (feet) 50'
- (3) static water level (feet) 111 below above top of ground.
- (4) casing P.V.C  
 (material) (depth)  
 (size) If telescope see back.
- (5) screen 5' 45'  
 (length) (depth to top)  
2" P.V.C  
 (size) (material)
- (6) pump 1/2 6  
 (HP) (yield gpm)  
Electric  
 (type power)
- (7) electric log NO  
 (yes or no)

(organization running log)

(8) how well bottom plugged Capped

DRILLERS REMARKS:


DEPT. OF NATURAL RESOURCES  
 BUREAU OF LAND & WATER RESOURCES

SEP 21 1982

RECEIVED

If well telescopes please sketch and show depths.

GROUND LEVEL

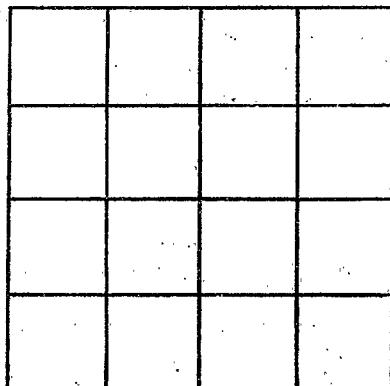

SECTION \_\_\_\_\_

Please indicate well location X.

ADDITIONAL INFORMATION

If more than one screen, show locations of each on sketch.