

Pearl River  
H 2013

MISSISSIPPI  
 BOARD OF WATER COMMISSIONERS  
 416 North State Street  
 Jackson, Mississippi 39201

WELL DRILLERS LOG

July 8 1982 Farmee Anderson Pearl River  
 date well completed firm name county well located

LANDOWNER: Joseph Graham

description of formations encountered

from to

Dot  
Lumberton, MS  
 (mailing address)

top soil	0	2
clay	2	21
sand	21	31
clay	31	110
sand	110	140

WELL LOCATION:

sec 20 T 2 R 14  
 S W  
9 1/2 miles E of Poplarville  
 (distance) (direction) (nearest town)

WELL PURPOSE: Home  
 (home, irrigation, municipal, industrial)

WELL COMPLETION DATA:

- (1) diameter (inches) 2"
- (2) total depth (feet) 140' ~~140'~~
- (3) static water level (feet) 120 below top of ground.
- (4) casing P.V.C. (material) (depth)
- (size) If telescope see back.
- (5) screen 5' 135' (length) (depth to top)
- 2" P.V.C. (size) (material)
- (6) pump 1 6 (HP) (yield gpm)
- Electric (type power)
- (7) electric log NO (yes or no)
- (organization running log)
- (8) how well bottom plugged Capped

DRILLERS REMARKS:


DEPT. OF NATURAL RESOURCES  
 BUREAU OF LAND & WATER RESOURCES

SEP 21 1982

RECEIVED

If well telescopes please sketch and show depths.

GROUND LEVEL

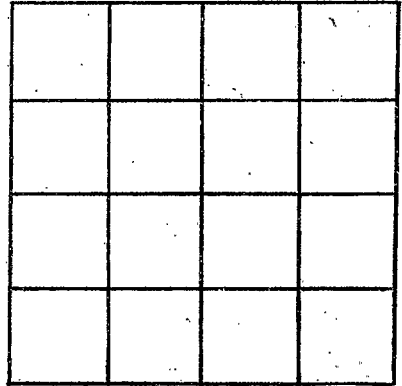

SECTION \_\_\_\_\_

Please indicate well location X.

ADDITIONAL INFORMATION

If more than one screen,  
show locations of each on sketch.