

Paul River  
H 2014

MISSISSIPPI DEPARTMENT OF NATURAL RESOURCES  
Bureau of Land and Water Resources  
Southport Mall  
P.O. Box 10631  
Jackson, Mississippi 39209  
**WATER WELL DRILLERS LOG**

12-29 1982  
date well completed

Frank Price  
firm name

Paul River  
county well located

LANDOWNER:  
Ken Lee  
  
(mailing address)  
  
WELL LOCATION:  
sec. 29 T. 2 N. R. 14 E.  
4 1/2 miles S of Ham Pond  
(distance) (direction) (nearest town)

description of formations encountered	from	to
<u>Top Soil</u>	<u>0</u>	<u>2</u>
<u>Red Clay</u>	<u>2</u>	<u>18</u>
<u>Coarse Sand</u>	<u>18</u>	<u>45</u>
<u>Clay</u>	<u>45</u>	<u>80</u>
<u>Flne Sand</u>	<u>80</u>	<u>95</u>
<u>Coarse Sand</u>	<u>95</u>	<u>107</u>

WELL PURPOSE: HOME  
(home, irrigation, municipal, industrial)

WELL COMPLETION DATA:  
(1) diameter (inches) 2"  
(2) total depth (feet) 107  
(3) static water level (feet) 90' below above top of ground.  
(4) casing Plastic, 102'  
(material) (depth)  
         If telescope see back.  
(size)  
(5) screen 5", 102'  
(length) (depth to top)  
2", Plastic  
(size) (material)  
(6) pump 1 6  
(HP) (yield gpm)  
Elect  
(type power)  
(7) electric log no  
(yes or no)  
          
(organization running log)  
(8) how well bottom plugged Backwash Valve

DRILLERS REMARKS:  
          
          
        


DEPT. OF NATURAL RESOURCES  
BUREAU OF LAND & WATER RESOURCES

JAN - 6 1983

RECEIVED

If well telescopes please sketch and show depths.

GROUND LEVEL

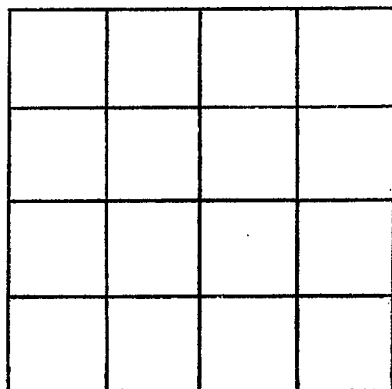

SECTION \_\_\_\_\_

Please indicate well location X.

ADDITIONAL INFORMATION

If more than one screen, show locations of each on sketch.