

Pearl River
H2015

MISSISSIPPI
 BOARD OF WATER COMMISSIONERS
 416 North State Street
 Jackson, Mississippi 39201

WATER WELL DRILLERS LOG

Sept 13 1982 Barney Anderson Pearl River
 date well completed firm name county well located

LANDOWNER: Cheryl R. Lee
Rt 3 Box 156
Lumberton, MS
 (mailing address)

description of formations encountered	from	to
	<u>top soil</u>	<u>0</u>
<u>Clay</u>	<u>2</u>	<u>19</u>
<u>sand</u>	<u>19</u>	<u>28</u>
<u>Clay</u>	<u>28</u>	<u>35</u>
<u>sand</u>	<u>35</u>	<u>50</u>

WELL LOCATION:
 sec. 20 T. 2 S. R. 14 W.
9 miles E of Poplarville
 (distance) (direction) (nearest town)

WELL PURPOSE: Home
 (home, irrigation, municipal, industrial)

- WELL COMPLETION DATA:
- (1) diameter (inches) 2"
 - (2) total depth (feet) 50'
 - (3) static water level (feet) 44' below top of ground.
 - (4) casing PVC (material), (depth) _____
 _____ (size) if telescope see back.
 - (5) screen 5 (length), 39' (depth to top)
2" (size), PVC (material)
 - (6) pump 1 (HP), 5 (yield gpm)
Electric (type power)
 - (7) electric log NO (yes or no)
 _____ (organization running log)
 - (8) how well bottom plugged Copper

DEPT. OF NATURAL RESOURCES
 BUREAU OF LAND & WATER RESOURCES


DRILLERS REMARKS:

FEB - 2 1983

RECEIVED

If well telescopes please sketch and show depths.

GROUND LEVEL

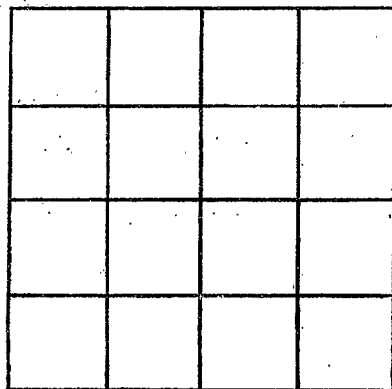

SECTION _____

Please indicate well location X.

ADDITIONAL INFORMATION

If more than one screen,
show locations of each on sketch.