

MISSISSIPPI DEPARTMENT OF NATURAL RESOURCES

Bureau of Land and Water Resources

Southport Mall

P.O. Box 10631

Jackson, Mississippi 39209

WATER WELL DRILLERS LOG

Pearl River  
H 2017


Dec. 30, 1982 date well completed      Cochran Bros. Drilling Service, Pearl River firm name               county well located

LANDOWNER:	description of formations encountered	from	to
<u>Bob Couney</u>			
<u>Rt 2 Lumberton</u> (mailing address)	<u>TOP soil</u>	<u>0</u>	<u>2</u>
	<u>GRAY CLAY</u>	<u>2</u>	<u>12</u>
	<u>sand</u>	<u>12</u>	<u>44</u>
	<u>blue clay</u>	<u>44</u>	<u>88</u>
	<u>sand</u>	<u>88</u>	<u>120</u>
WELL LOCATION:			
sec. <u>28</u> T <u>2</u> N R. <u>14</u> E			
<u>5</u> miles <u>E</u> of <u>Poplarville</u>			
(distance) (direction) (nearest town)			
WELL PURPOSE:			
<u>(home)</u> irrigation, municipal, industrial			
WELL COMPLETION DATA:			
(1) diameter (inches) <u>2"</u>			
(2) total depth (feet) <u>120'</u>			
(3) static water level (feet) <u>90</u> below above top of ground.			
(4) casing <u>PVC 110'</u> (material) (depth)			
<u>7</u> If telescope see back. (size)			
(5) screen <u>10' 110'</u> (length) (depth to top)			
<u>2</u> <u>PVC</u> (size) (material)			
(6) pump <u>1</u> <u>3</u> (HP) (yield gpm)			
<u>elec</u> (type power)			
(7) electric log <u>no</u> (yes or no)			
<u>        </u> (organization running log)			
(8) how well bottom plugged <u>also</u>			
DRILLERS REMARKS:			

DEPT. OF NATURAL RESOURCES  
BUREAU OF LAND & WATER RESOURCES  
FEB 10 1983  
RECEIVED

If well telescopes please sketch and show depths.

GROUND LEVEL

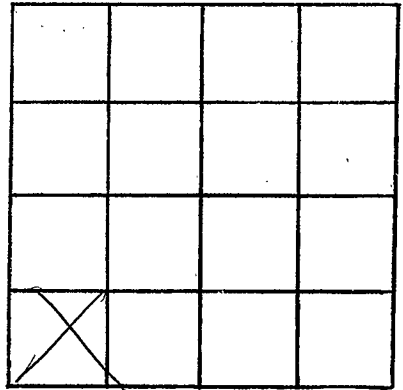

SECTION 28

Please indicate well location X.

ADDITIONAL INFORMATION

If more than one screen,  
show locations of each on sketch.