

MISSISSIPPI DEPARTMENT OF NATURAL RESOURCES

Bureau of Land and Water Resources

Southport Mall

P.O. Box 10631

Jackson, Mississippi 39209

WATER WELL DRILLERS LOG

PEARL RIVER
H 2019

Dec. 17

1984 P. ANDERSON

Pearl River

date well completed

firm name

county well located

LANDOWNER: Jesse Oudeaury

Rt 3, Box 157

Jumberton MS
(mailing address)

description of formations encountered

Top Soil
Clay
Sand
Clay
Sand

from

to

2 - 2
2 - 21
31 - 40
40 - 79
79 - 98


WELL LOCATION:

sec 21 T. 2 N R. 14 E
S W
9 miles E of Poplarville
(distance) (direction) (nearest town)

WELL PURPOSE: home
(home, irrigation, municipal, industrial)

WELL COMPLETION DATA:

- (1) diameter (inches) 2"
- (2) total depth (feet) 98'
- (3) static water level (feet) 95' below top of ground.
- (4) casing P.V.C. 93'
(material) (depth)
- (size) If telescope see back.
- (5) screen 5' 93'
(length) (depth to top)
- 2" P.V.C.
(size) (material)
- (6) pump 1
(HP) (yield gpm)
- Electric
(type power)
- (7) electric log NO
(yes or no)

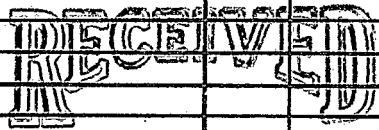

JUN 1 1986

Department of Natural Resources
Bureau of Land & Water Resources

(organization running log)

(8) how well bottom plugged Copper

DRILLERS REMARKS:

