

MISSISSIPPI DEPARTMENT OF NATURAL RESOURCES

Bureau of Land and Water Resources

Southport Mall

P.O. Box 10631

Jackson, Mississippi 39209

WATER WELL DRILLERS LOG

Pear River
H 2022

8-27 1988 POUNCEY WATER WELL DRILLING Pear River
date well completed firm name county well located

LANDOWNER: John Thibod
Poplarville Rd

description of formations encountered

from

to

(mailing address)

WELL LOCATION:

sec 24 T 2 N R 14 E
3 miles E of Poplarville
(distance) (direction) (nearest town)

top 0 8
2' ground 8 18
base clay 18 60
slt. 60 112
clay 112 131
slt to fine 131 172
fine to good slt. 172 210

WELL PURPOSE: house
(home, irrigation, municipal, industrial)

WELL COMPLETION DATA:

- (1) diameter (inches) 2
- (2) total depth (feet) 210
- (3) static water level (feet) 99 below top of ground.
- (4) casing PVC 200
(material) (depth)
2
(size) If telescope see back.
- (5) screen 10 200
(length) (depth to top)
2 PVC
(size) (material)
- (6) pump 1 1/2 6
(HP) (yield gpm)
AC
(type power)
- (7) electric log (yes or no)

(organization running log)

(8) how well bottom plugged

DRILLERS REMARKS: slow


DEPT. OF NATURAL RESOURCES
BUREAU OF LAND & WATER RESOURCES

SEP 10 1984

RECEIVED

If well telescopes please
sketch and show depths.

GROUND LEVEL

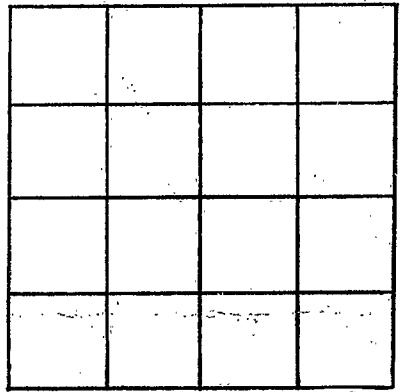

SECTION _____

Please indicate well location X.

ADDITIONAL INFORMATION

If more than one screen,
show locations of each on sketch.