

MISSISSIPPI DEPARTMENT OF NATURAL RESOURCES
Bureau of Land and Water Resources
 Southport Mall
 P.O. Box 10631
 Jackson, Mississippi 39209
WATER WELL DRILLERS LOG

PEARL RIVER
H 2026

1/11 1985 date well completed **BUD PENTON & SO.** Pearl River
 Water Well Service county well located
 Rt. 4, Box 402

LANDOWNER: Lewis Williams
Reparwith Lumpford
Road
 (mailing address)

Description of Strata Encountered	from	to
<u>Red shale</u>	<u>0</u>	<u>80</u>
<u>Red sand</u>	<u>80</u>	<u>120</u>
<u>Blue shale</u>	<u>120</u>	<u>255</u>
<u>Grey sand</u>	<u>255</u>	<u>302</u>

WELL LOCATION:
 sec. 21 T. 2 N R. 14 E
4 miles N of Prentiss
 (distance) (direction) (nearest town)

WELL PURPOSE: None
 (home, irrigation, municipal, industrial)

- WELL COMPLETION DATA:
- diameter (inches) 4"
 - total depth (feet) 302
 - static water level (feet) 120 below above top of ground.
 - casing PVC, 302
 (material) (depth)
 (size) if telescope see back.
 - screen 10', 292
 (length) (depth to top)
12, PVC
 (size) (material)
 - pump 1, 900
 (HP) (yield gpm)
Elect
 (type power)
 - electric log no
 (yes or no)

(organization running log)
 (8) how well bottom plugged good
shore


DRILLERS REMARKS:

RECEIVED
 FEB 12 1986

Department of Natural Resources
 Bureau of Land & Water Resources

If well telescopes please sketch and show depths.

GROUND LEVEL

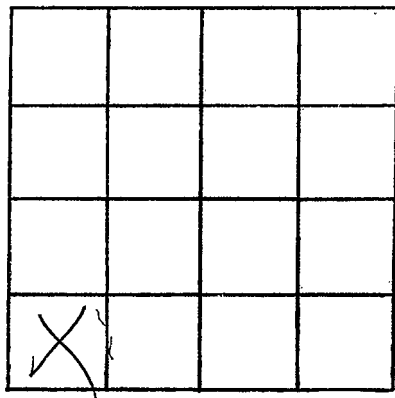

SECTION _____

Please indicate well location X.

ADDITIONAL INFORMATION

If more than one screen, show locations of each on sketch.