

MISSISSIPPI DEPARTMENT OF NATURAL RESOURCES
Bureau of Land and Water Resources
 Southport Mall
 P.O. Box 10631
 Jackson, Mississippi 39209
WATER WELL DRILLERS LOG

Pearl River
H 2007

1/6 1986 date well completed firm name Pearl River
 county well located

LANDOWNER: SE WEIGAND
R.T. 2 Box 299 Poplarville
Miss 39478
 (mailing address)

description of formations encountered	from to	
<u>Red shale</u>	<u>0</u>	<u>12</u>
<u>White sand</u>	<u>12</u>	<u>20</u>
<u>Blue shale</u>	<u>20</u>	<u>110</u>
<u>White sand</u>	<u>110</u>	<u>162</u>
<u>Blue shale</u>	<u>162</u>	<u>680</u>
<u>Blue sand</u>	<u>680</u>	<u>714</u>

WELL LOCATION:
 sec. 28 T. 2 S. R. 14 E. W. 5
5 miles (distance) E (direction) of Poplarville (nearest town)

WELL PURPOSE: home
 (home, irrigation, municipal, industrial)

- WELL COMPLETION DATA:
- (1) diameter (inches) 4
 - (2) total depth (feet) 714
 - (3) static water level (feet) 70 below/above top of ground.
 - (4) casing PVC (material), 714 (depth), 4x2 (size) if telescope see back.
 - (5) screen 15 (length), 699 (depth to top), 10 (size), PVC (material)
 - (6) pump 1 (HP), 960 (yield gpm)
- (type power)
- (7) electric log 960 (yes or no)
- (organization running log)
- (8) how well bottom plugged sand
shark


RECEIVED
FEB 12 1986

Department of Natural Resources
 Bureau of Land & Water Resources

DRILLERS REMARKS:

If well telescopes please sketch and show depths.

GROUND LEVEL

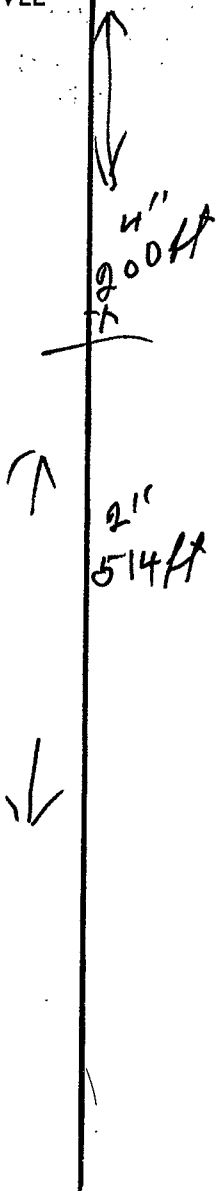

	7		

SECTION _____

Please indicate well location X.

ADDITIONAL INFORMATION

If more than one screen,
show locations of each on sketch.