

MISSISSIPPI DEPARTMENT OF NATURAL RESOURCES

Bureau of Land and Water Resources

Southport Mall

P.O. Box 10631

Jackson, Mississippi 39209

WATER WELL DRILLERS LOG

Pearl River
H20028

4-25 1986 Parnell Anderson Pearl River
date well completed firm name county well located

LANDOWNER: M. C. Ballard

P.O. Box 523
Poplarville Miss
(mailing address)

WELL LOCATION:

sec. 4 T. 2 ^{HP} S R. 14 ^E W
12 miles E of Poplarville
(distance) (direction) (nearest town)

WELL PURPOSE: Home
(home, irrigation, municipal, industrial)


WELL COMPLETION DATA:

- (1) diameter (inches) 2
- (2) total depth (feet) 248
- (3) static water level (feet) 105 below top of ground.
- (4) casing PVC, 238,
(material) (depth)
(size) if telescope see back.
- (5) screen 10, 238
(length) (depth to top)
2, PVC
(size) (material)
- (6) pump 2, 7
(HP) (yield gpm)
Elec
(type power)
- (7) electric log NO
(yes or no)
(organization running log)
- (8) how well bottom plugged Backwash
valve

description of formations encountered

from to

Top Soil	0	2
Clay	2	16
Sand	16	24
Clay	24	68
Sand	68	92
Blue Clay	92	224
Sand	224	248

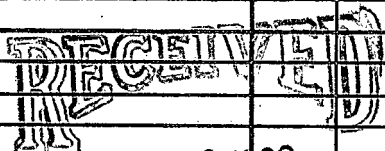


JUN 12 1986

Department of Natural Resources
Bureau of Land & Water Resources

DRILLERS REMARKS:

If well telescopes please sketch and show depths.

GROUND LEVEL

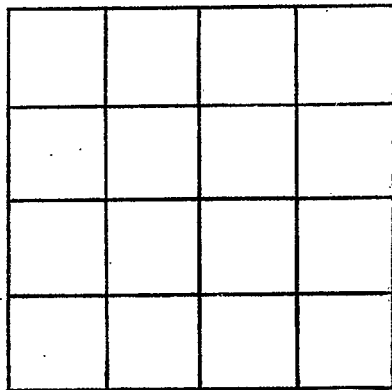

SECTION _____

Please indicate well location X.

ADDITIONAL INFORMATION

If more than one screen,
show locations of each on sketch.