

MISSISSIPPI DEPARTMENT OF NATURAL RESOURCES

Bureau of Land and Water Resources

Southport Mall

P.O. Box 10631

Jackson, Mississippi 39209

WATER WELL DRILLERS LOG

PEARL RIVER
H2029

3-21 1986 Parnell Anderson Pearl River
date well completed firm name county well located


LANDOWNER: Dan Davis
Lumberton
MISS
(mailing address)

| description of formations encountered | from | to |
|---------------------------------------|-----------|-----------|
| <u>top soil</u> | <u>0</u> | <u>2</u> |
| <u>sand</u> | <u>2</u> | <u>19</u> |
| <u>clay</u> | <u>19</u> | <u>25</u> |
| <u>sand & gravel</u> | <u>25</u> | <u>63</u> |

WELL LOCATION:
sec. 13 T. 2 S. R. 14 E. W.
14 miles E of Poplarville
(distance) (direction) (nearest town)

WELL PURPOSE: Home
(home, irrigation, municipal, industrial)

- WELL COMPLETION DATA:
- (1) diameter (inches) 2
 - (2) total depth (feet) 63
 - (3) static water level (feet) 30 below above top of ground.
 - (4) casing PVC, 58,
(material) (depth)
(size) if telescope see back.
 - (5) screen 5, 58
(length) (depth to top)
(size) (material)
 - (6) pump 1/2, 5
(HP) (yield gpm)
Elec
(type power)
 - (7) electric log NO
(yes or no)
(organization running log)
 - (8) how well bottom plugged Cap.

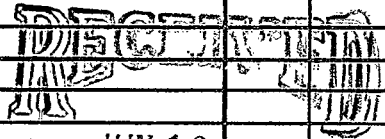


JUN 12 1986

Department of Natural Resources
Bureau of Land and Water Resources

DRILLERS REMARKS:

If well telescopes please sketch and show depths.

GROUND LEVEL

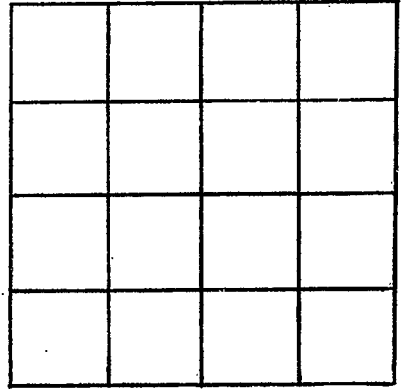

SECTION _____

Please indicate well location X.

ADDITIONAL INFORMATION

If more than one screen,
show locations of each on sketch.