

MISSISSIPPI DEPARTMENT OF NATURAL RESOURCES
Bureau of Land and Water Resources

P.O. Box 10631
Jackson, Mississippi 39209
WATER WELL DRILLERS LOG

COUNTY WELL LOCATED PEARL RIVER	
WELL NUMBER H 2030	CODED
DATE WELL COMPLETED 3-28-88	

PERMIT NUMBER 0428
NAME OF DRILLING FIRM WALKER WELL SERVICE

NAME & MAILING ADDRESS OF LANDOWNER E. and AS MITCHELL RT 1 CARRIERS MS.			
WELL LOCATION: SEC	TOWNSHIP	RANGE	
9	2	N 14	W
DISTANCE	DIRECTION	NEAREST TOWN	
16 Miles	N	of P. CAYDOME	
OTHER LANDMARK HENLEEFIELD			
WELL PURPOSE <u>Home Irrigation</u> , Municipal, Industrial, Fish Pond, etc.			

PUMP DATA		
PUMP TYPE (Circle One): <input checked="" type="radio"/> Submersible Turbine, Jet Flowing Well, Other (Describe) _____		
POWER TYPE (Circle One): <input checked="" type="radio"/> Electric Tractor, Diesel, Gasoline, Butane, Other (Describe) _____		
Pump Capacity (GPM)	No. of Stages	Setting Depth
		FT.
PUMP TEST		
Well yielded _____ GPM with a drawdown of _____ ft. after _____ hours of pumping		

WELL DATA.		
Well Depth 180'	Casing Diameter (In.) 4"	Casing Length (Ft.) 160
Type of Casing POC	Hole Depth 182	Depth to Static Water Level
TYPE OF COMPLETION: (Circle One or More): Gravel Packed, Underreamed, Telescoped, <input checked="" type="radio"/> Natural Development, Open Hole, Other (Describe) AIR		
Top of Lap Pipe or Reduction in Casing		
FEET	IF TELESCOPED OR MORE THAN ONE SCREEN: USE BACK PAGE	

LOG DATA	
TYPE OF LOG RUN (Circle One): No Log Run, Electric, Gamma Ray, Density, Sonic, Neutron, Other (Describe) _____	
Name of Organization Running Log	

SCREEN DATA		
Diameter - Inches 4"	Length - Feet 10'	Slot Size - Inches #10
Screen Type SLOT	Depth to Bottom - Feet 180'	


GEOLOGIC DATA (Office Use Only)			
Surface Elev.	Geologic Unit	Unit Thickness	Depth to Top
Subs. SWL	Date	Analysis	Aquifer Test
Driller's Remarks			

DESCRIPTION OF FORMATIONS ENCOUNTERED	FROM	TO	FORMATIONS / CONTINUED	FROM	TO
SAND	0	15	DRILLED APR 15 1988 Department of Natural Resources Bureau of Land & Water Resources		
WHITE CLAY	15	165			
SAND	165	180			

IF MORE SPACE IS NEEDED, USE BACK

If well telescopes please sketch and show depths.

GROUND LEVEL

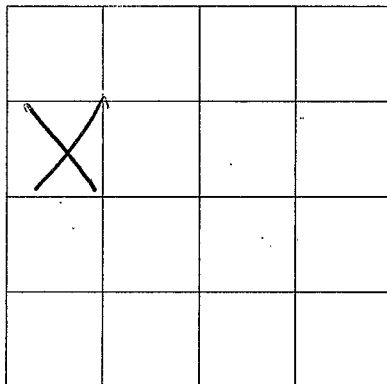

SECTION _____

Please indicate well location X.

ADDITIONAL INFORMATION

If more than one screen,
show location of each on sketch.