

MISSISSIPPI DEPARTMENT OF NATURAL RESOURCES

Bureau of Land and Water Resources

Southport Mall

P.O. Box 10631

Jackson, Mississippi 39209

WATER WELL DRILLERS LOG

P. RIVER
H 2032

9/23 date well completed

1990 Bud Denton firm name

Pearl River county well located


LANDOWNER: Ronald McDonald
Bios: 26 Poplarville
Miss. (mailing address)

description of formations encountered	from to	
Red shale	0	60
White shale	40	65
Red sand	65	118

WELL LOCATION:
sec. 19 T. 2 N R. 14 E
8 miles East of Poplarville
(distance) (direction) (nearest town)

WELL PURPOSE: Home
(home, irrigation, municipal, industrial)

- WELL COMPLETION DATA:
- (1) diameter (inches) 4
 - (2) total depth (feet) 118
 - (3) static water level (feet) 80 below top of ground.
 - (4) casing PVC, 118 (material) (depth)
(size) if telescope see back.
 - (5) screen 10, 108 (length) (depth to top)
12, PVC (size) (material)
 - (6) pump 1/2 (HP) 12 (yield gpm)
Elect (type power)
 - (7) electric log no (yes or no)
 - (8) how well bottom plugged (organization running log)

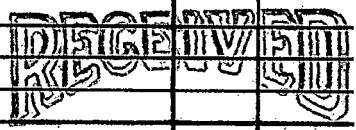


FEB 10 1991

Dept. of Environmental Quality
Bureau of Land & Water Resources

DRILLERS REMARKS:

If well telescopes please sketch and show depths.

GROUND LEVEL

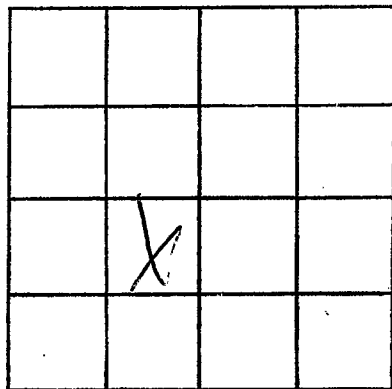

SECTION _____

Please indicate well location X.

ADDITIONAL INFORMATION

If more than one screen,
show locations of each on sketch.