

MISSISSIPPI DEPARTMENT OF NATURAL RESOURCES
 Bureau of Land and Water Resources
 Southport Mall
 P.O. Box 10631
 Jackson, Mississippi 39209
WATER WELL DRILLERS LOG

PR
H 2034


2/24 1992 Bud Denton Pearl River
 date well completed firm name county well located

LANDOWNER: Jal Carroll
Box 26 Gumpers
Rt 1 P.O. Box 733
Deerfield (mailing address)
 WELL LOCATION:
 sec. 14 T. 2 N. R. 14 E.
14 miles East Deerfield
 (distance) (direction) (nearest town)

description of formations encountered	from	to
<u>Red Shale</u>	<u>0</u>	<u>10</u>
<u>Red sand</u>	<u>10</u>	<u>120</u>
<u>Blue shale</u>	<u>120</u>	<u>225</u>
<u>Gray sand</u>	<u>225</u>	<u>263</u>

WELL PURPOSE: home
 (home, irrigation, municipal, industrial)

- WELL COMPLETION DATA:
- (1) diameter (inches) 4"
 - (2) total depth (feet) 263
 - (3) static water level (feet) 84 below top of ground.
 - (4) casing pvc, 263,
 (material) (depth)
 - 4x2 If telescope see back.
 (size)
 - (5) screen 10, 253
 (length) (depth to top)
 - 12, pvc
 (size) (material)
 - (6) pump 1/2, 12
 (HP) (yield gpm)
 - Elect
 (type power)
 - (7) electric log no
 (yes or no)
 - (organization running log)
 - (8) how well bottom plugged Sand
sharp

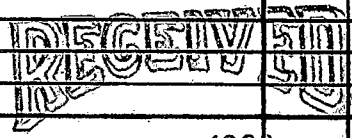


APR 29 1992

Dept. of Environmental Quality
 Bureau of Land & Water Resources

DRILLERS REMARKS:

If well telescopes please sketch and show depths.

GROUND LEVEL

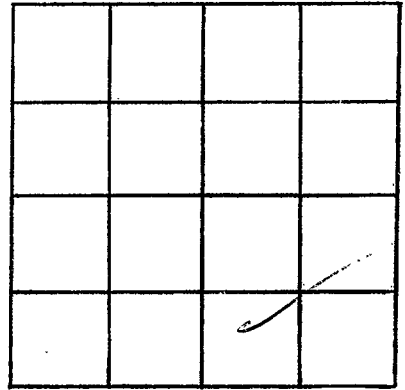

SECTION 14

Please indicate well location X.

ADDITIONAL INFORMATION

If more than one screen, show locations of each on sketch.