

MISSISSIPPI DEPARTMENT OF NATURAL RESOURCES

Bureau of Land and Water Resources

Southport Mall

P.O. Box 10631

Jackson, Mississippi 39209

WATER WELL DRILLERS LOG

*Allen*

H 2037

10-12 19 92 Bud Penton Water Well Pearl River  
 date well completed firm name county well located

LANDOWNER: Bill Jordan

281 Ed Jones Rd

Lumberton Ms 39455  
 (mailing address)

WELL LOCATION:

sec. 11 T. 2 N. R. 14 E.  
 (S) (W)  
5 miles south of Lumberton  
 (distance) (direction) (nearest town)

WELL PURPOSE: Home  
 (home, irrigation, municipal, industrial)

WELL COMPLETION DATA:

- (1) diameter (inches) 4 X 2
- (2) total depth (feet) 280
- (3) static water level (feet) 72 below above top of ground.
- (4) casing PVC, 270,  
 (material) (depth)  
4 X 2 if telescope see back.  
 (size)
- (5) screen 10, 270  
 (length) (depth to top)  
2", PVC  
 (size) (material)
- (6) pump 1, 20  
 (HP) (yield gpm)  
electric  
 (type power)
- (7) electric log NO  
 (yes or no)

(organization running log)


(8) how well bottom plugged sandshark

DRILLERS REMARKS:

description of formations encountered

from to

White Clay	0	28
White sand	28	60
blue clay	60	250
GRAY SAND	250	280

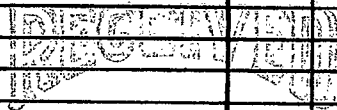


FEB 25 1993

Dept. of Environmental Quality  
 Office of Land & Water Resources

If well telescopes please sketch and show depths.

GROUND LEVEL

160' 4"  
120' 2"

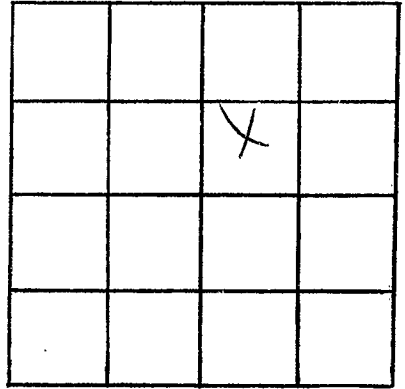

SECTION \_\_\_\_\_

Please indicate well location X.

ADDITIONAL INFORMATION

If more than one screen,  
show locations of each on sketch.