

MISSISSIPPI DEPARTMENT OF NATURAL RESOURCES

Bureau of Land and Water Resources

Southport Mall

P.O. Box 10631

Jackson, Mississippi 39209

WATER WELL DRILLERS LOG

P. RIVER  
H 2039

7-28-1992 Bud Penton Water Well Pearl River  
date well completed firm name county well located


LANDOWNER: Bill Jordan  
315 Red GAP Rd.  
Perkinston, MS. Hillsdale Ms.  
Otha Davis Rd  
(mailing address)

description of formations encountered	from	to
red shale	0	18
red sand	18	25
White shale	25	185
White sand	185	202

WELL LOCATION:  
sec. 3 T 2 N R 14 E  
2 1/2 miles EAST of Gumpond  
(distance) (direction) (nearest town)

WELL PURPOSE: Home  
(home, irrigation, municipal, industrial)

- WELL COMPLETION DATA:
- (1) diameter (inches) 7
  - (2) total depth (feet) 202
  - (3) static water level (feet) 66 below top of ground.
  - (4) casing PVC, 192 (material), (depth)  
4" if telescope see back. (size)
  - (5) screen 10, 192 (length), (depth to top)  
4" PVC (size), (material)
  - (6) pump 1/2, 10 (HP), (yield gpm)  
electric (type power)
  - (7) electric log NO (yes or no)  
(organization running log)
  - (8) how well bottom plugged sandshark

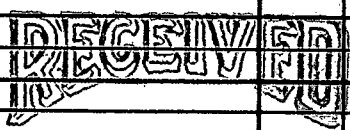

AUG 19 1992

Dept. of Environmental Quality  
Bureau of Land & Water Resources

DRILLERS REMARKS:

If well telescopes please sketch and show depths.

GROUND LEVEL

	X		

SECTION 3

Please indicate well location X.

ADDITIONAL INFORMATION

If more than one screen,  
show locations of each on sketch.