

MISSISSIPPI DEPARTMENT OF NATURAL RESOURCES

Bureau of Land and Water Resources

Southport Mall

P.O. Box 10631

Jackson, Mississippi 39209

WATER WELL DRILLERS LOG

P. River

H 2040

6-5 1992 Bud Penton Well Serv. Pearl River  
 date well completed firm name county well located

LANDOWNER: Joy SA Sansone

description of formations encountered	from	to
red shale	0	18
red sand	18	50
white shale	50	100
white sand	100	230

Sandy Hill Rd Poplarville  
 (mailing address)


WELL LOCATION:

sec. 14 T. 2 N. R. 14 E.  
 9 miles EAST of Poplarville  
 (distance) (direction) (nearest town)

WELL PURPOSE: Home  
 (home, irrigation, municipal, industrial)

WELL COMPLETION DATA:

- (1) diameter (inches) 4" x 2"
- (2) total depth (feet) 230
- (3) static water level (feet) 100 <sup>below</sup> above top of ground.
- (4) casing PVC 190  
 (material) (depth)  
4" x 2" if telescope see back.  
 (size)
- (5) screen 10 190  
 (length) (depth to top)  
2" PVC  
 (size) (material)
- (6) pump 1 14  
 (HP) (yield gpm)  
electric  
 (type power)
- (7) electric log NO  
 (yes or no)  
 (organization running log)
- (8) how well bottom plugged sandshack

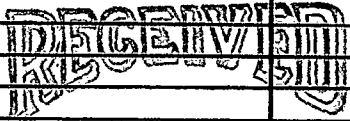

SEP 18 1992

Dept. of Environmental Quality  
 Bureau of Land & Water Resources

DRILLERS REMARKS:

