

MISSISSIPPI DEPARTMENT OF ENVIRONMENTAL QUALITY

Office of Land and Water Resources

P. O. Box 10631
Jackson, MS 39289-0631
WATER WELL DRILLERS LOG

COUNTY WELL LOCATED <u>Pearl River</u>	
WELL NUMBER <u>#</u>	CODED
DATE WELL COMPLETED <u>2043</u> <u>6-14-93</u>	

PERMIT NUMBER
NAME OF DRILLING FIRM <u>Bud Penton & Son</u> <u>Water Well Service</u>

NAME & MAILING ADDRESS OF LANDOWNER <u>Ron Cuccia</u> <u>127 Sandy Hill Rd</u> <u>Poplarville Ms 39470</u>			
WELL LOCATION:	SEC	TOWNSHIP	RANGE
	<u>14</u>	<u>2</u> <u>N</u>	<u>14</u> <u>W</u>
DISTANCE	DIRECTION	NEAREST TOWN	
<u>9</u> Miles	<u>E</u>	of <u>Poplarville</u>	
OTHER LANDMARK			
WELL PURPOSE: Home, Irrigation, Municipal, Industrial, Fish Pond, etc. <u>Home</u>			

PUMP DATA		
PUMP TYPE (Circle One): <u>Submersible</u> , Turbine, Jet, Flowing Well, Other (Describe) _____		
POWER TYPE (Circle One): <u>Electric</u> , Tractor, Diesel, Gasoline, Butane, Other (Describe) _____ H/P <u>1</u>		
Pump Capacity (GPM) <u>18</u>	No. of Stages <u>9</u>	Setting Depth <u>125</u> FT.
PUMP TEST		
Well yielded _____ GPM with a drawdown of _____ ft. after _____ hours of pumping		

WELL DATA		
Well Depth <u>250</u>	Casing Diameter (In.) <u>4</u>	Casing Length (Ft.) <u>240</u>
Type of Casing <u>PVC</u>	Hole Depth <u>250</u>	Depth to Static Water Level <u>102'</u>
TYPE OF COMPLETION: (Circle One or More): <u>Gravel Packed</u> , Underreamed, Telescoped, <u>Natural Development</u> , Open Hole, Other		

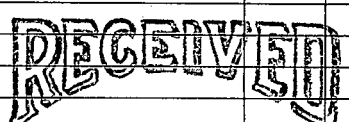
LOG DATA	
TYPE OF LOG RUN (Circle One): Electric, Gamma Ray, Density, Sonic, <u>No Log Run</u> , Other (Describe) _____	
Name of Organization Running Log	

WELL GROUTED TO A DEPTH OF <u>10</u> FEET Type Grout (circle one): <u>Cement</u> , Bentonite, or Mix

GEOLOGIC DATA (Office Use Only)			
Surface Elev.	Geologic Unit	Unit Thickness	Depth to Top
Subs. SWL	Date	Analysis	Aquifer Test

SCREEN DATA		
Diameter - Inches <u>2</u>	Length - Feet <u>10</u>	Slot Size - Inches <u>.012</u>
Screen Type <u>PVC</u>	Depth to Bottom - Feet <u>250</u>	

Driller's Remarks

DESCRIPTION OF FORMATIONS ENCOUNTERED	FROM	TO	FORMATIONS (Continued)	FROM	TO
<u>red sand</u>	<u>0</u>	<u>5</u>	 SEP 20 1993 Dept. of Environmental Quality Office of Land & Water Resources		
<u>white clay</u>	<u>5</u>	<u>45</u>			
<u>red sand</u>	<u>45</u>	<u>110</u>			
<u>Blue clay</u>	<u>110</u>	<u>210</u>			
<u>Gray sand</u>	<u>210</u>	<u>250</u>			

IF MORE SPACE IS NEEDED, USE BACK

If well telescopes please sketch and show depths.

GROUND LEVEL

		X	

SECTION 14

Please indicate well location X.

ADDITIONAL INFORMATION

If more than one screen,
show location of each on sketch.