

**MISSISSIPPI DEPARTMENT OF ENVIRONMENTAL QUALITY**  
Bureau of Land and Water Resources

P. O. Box 10631  
Jackson, MS 39289-0631  
**WATER WELL DRILLERS LOG**

COUNTY WELL LOCATED <u> Pearl River </u>	
WELL NUMBER <u> H </u>	CODED
DATE WELL COMPLETED <u> 2045 </u> <u> 5-13-94 </u>	

PERMIT NUMBER
NAME OF DRILLING FIRM <u> GODNE'S Water Well </u>

NAME & MAILING ADDRESS OF LANDOWNER <u> Eddy Williamson </u>		
<u> 39 Nelson Rd. </u>		
<u> Poplarville, MS </u>		
WELL LOCATION:	SEC	TOWNSHIP
	<u> 29 </u>	<u> 2 </u>
		RANGE
		<u> 14 </u>
DISTANCE	DIRECTION	NEAREST TOWN
<u> 10 </u>	<u> E </u>	<u> Poplarville </u>
Miles	of	
OTHER LANDMARK		
WELL PURPOSE (Home) Irrigation, Municipal, Industrial, Fish Pond, etc.		

PUMP DATA		
PUMP TYPE (Circle One): <u> Submersible </u> , Turbine, Jet, Flowing Well, Other (Describe) _____		
POWER TYPE (Circle One): <u> Electric </u> , Tractor, Diesel, Gasoline, Butane, Other (Describe) _____ H/P <u> 1 1/2 </u>		
Pump Capacity (GPM)	No. of Stages	Setting Depth
		FT.
PUMP TEST		
Well yielded _____ GPM with a drawdown of _____ ft. after _____ hours of pumping		


WELL DATA		
Well Depth <u> 140ft. </u>	Casing Diameter (In.) <u> 4 </u>	Casing Length (Ft.) <u> 120 </u>
Type of Casing <u> sch 40 </u>	Hole Depth <u> 140 </u>	Depth to Static Water Level
TYPE OF COMPLETION: (Circle One or More): <u> Gravel Packed </u> , Underreamed, Telescoped, Natural Development, Open Hole, Other		
Top of Lap Pipe or Reduction in Casing		
FEET	IF TELESCOPED OR MORE THAN ONE SCREEN: USE BACK PAGE	

LOG DATA	
TYPE OF LOG RUN (Circle One): No Log Run, Electric, Gamma Ray, Density, Sonic, Neutron, Other (Describe) _____	
Name of Organization Running Log	

SCREEN DATA		
Diameter - Inches <u> 4 </u>	Length - Feet <u> 20 </u>	Slot Size - Inches <u> 10 </u>
Screen Type <u> sch 40 </u>	Depth to Bottom - Feet	


GEOLOGIC DATA (Office Use Only)			
Surface Elev.	Geologic Unit	Unit Thickness	Depth to Top
Subs. SWL	Date	Analysis	Aquifer Test
Driller's Remarks			

DESCRIPTION OF FORMATIONS ENCOUNTERED	FROM	TO
<u> Clay </u>	<u> 0 </u>	<u> 10 </u>
<u> Sand </u>	<u> 10 </u>	<u> 30 </u>
<u> Clay </u>	<u> 30 </u>	<u> 90 </u>
<u> Sand </u>	<u> 90 </u>	<u> 140 </u>

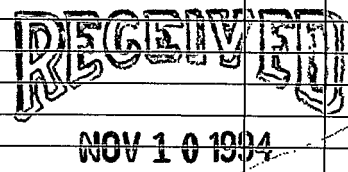FORMATIONS (Continued)	FROM	TO
		
NOV 10 1994		
Dept. of Environmental Quality Office of Land & Water Resources		
IF MORE SPACE IS NEEDED, USE BACK		

If well telescopes please  
sketch and show depths.

GROUND LEVEL

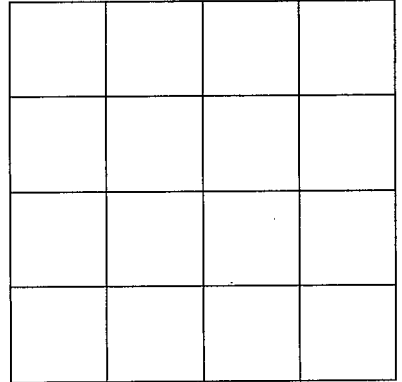

SECTION \_\_\_\_\_

Please indicate well location X.

ADDITIONAL INFORMATION

If more than one screen,  
show location of each on sketch.