

# MISSISSIPPI DEPARTMENT OF NATURAL RESOURCES

Bureau of Land and Water Resources

P.O. Box 10631

Jackson, Mississippi 39209

WATER WELL DRILLERS LOG

|  |       |
|--|-------|
| COUNTY/WELL LOCATED<br><i>Pearl River</i>            |       |
| WELL NUMBER<br><i>A</i>                              | CODED |
| DATE WELL COMPLETED<br><i>2052</i><br><i>3/10/95</i> |       |

|  |
|--|
| PERMIT NUMBER                          |
| NAME OF DRILLING FIRM<br><i>WALKER</i> |

|  |           |                    |  |
|--|-----------|--------------------|--|
| NAME & MAILING ADDRESS OF LANDOWNER<br><i>Sam Albritton</i>            |           |                    |  |
| <i>Pearl River, Stone County line</i>                                  |           |                    |  |
| <i>North Hwy. 26</i>   |           |                    |  |
| WELL LOCATION: SEC   | TOWNSHIP  | RANGE              |  |
| <i>24</i>  | <i>2</i>  | <i>S 014 W</i>     |  |
| DISTANCE   | DIRECTION | NEAREST TOWN       |  |
| <i>County line</i>   | <i>of</i> | <i>Pearl River</i> |  |
| OTHER LANDMARK   |           |                    |  |
| WELL PURPOSE: Home, Irrigation, Municipal, Industrial, Fish Pond, etc. |           |                    |  |

|   |               |               |
|---|---------------|---------------|
| PUMP DATA   |               |               |
| PUMP TYPE (Circle One):<br>Submersible, Turbine, <input checked="" type="radio"/> Jet, Flowing Well,<br>Other (Describe) _____      |               |               |
| POWER TYPE (Circle One):<br><input checked="" type="radio"/> Electric, Tractor, Diesel, Gasoline, Butane,<br>Other (Describe) _____ |               |               |
| Pump Capacity (GPM)   | No. of Stages | Setting Depth |
|   |               | FT.           |
| PUMP TEST   |               |               |
| Well yielded _____ GPM with   |               |               |
| a drawdown of _____ ft.   |               |               |
| after _____ hours of pumping  |               |               |

|   |  |   |
|---|--|---|
| WELL DATA   |  |   |
| Well Depth<br><i>95'</i>  | Casing Diameter (In.)<br><i>2"</i>                   | Casing Length (Ft.)<br><i>85'</i>         |
| Type of Casing<br><i>PVC</i>  | Hole Depth<br><i>95'</i>                             | Depth to Static Water Level<br><i>72'</i> |
| TYPE OF COMPLETION: (Circle One or More):<br>Gravel Packed, Underreamed, Telescoped,<br>Natural Development, Open Hole, Other<br>(Describe) _____ |  |   |
| Top of Lap Pipe or Reduction in Casing  |  |   |
| FEET  | IF TELESCOPED OR MORE THAN ONE SCREEN: USE BACK PAGE |   |

|  |  |
|--|--|
| LOG DATA   |  |
| TYPE OF LOG RUN (Circle One):<br>No Log Run, Electric, Gamma Ray, Density, Sonic, Neutron,<br>Other (Describe) _____ |  |
| Name of Organization Running Log   |  |

|                   |                        |                    |
|-------------------|------------------------|--------------------|
| SCREEN DATA       |                        |                    |
| Diameter - Inches | Length - Feet          | Slot Size - Inches |
|                   |                        |                    |
| Screen Type       | Depth to Bottom - Feet |                    |
|                   |                        |                    |

|                                 |               |                |              |
|---------------------------------|---------------|----------------|--------------|
| GEOLOGIC DATA (Office Use Only) |               |                |              |
| Surface Elev.                   | Geologic Unit | Unit Thickness | Depth to Top |
| Subs. SWL                       | Date          | Analysis       | Aquifer Test |
| Driller's Remarks               |               |                |              |
|                                 |               |                |              |
|                                 |               |                |              |

| DESCRIPTION OF FORMATIONS ENCOUNTERED | FROM      | TO        | FORMATIONS ENCOUNTERED | FROM | TO |
|---------------------------------------|-----------|-----------|------------------------|------|----|
| <i>Red Clayish sand</i>               | <i>0</i>  | <i>30</i> |                        |      |    |
| <i>Red Sand gravel</i>                | <i>30</i> | <i>36</i> |                        |      |    |
| <i>White red clay</i>                 | <i>36</i> | <i>72</i> |                        |      |    |
| <i>good sand</i>                      | <i>72</i> | <i>95</i> |                        |      |    |
| <i>Did not set pump.</i>              |           |           |                        |      |    |
|                                       |           |           |                        |      |    |
|                                       |           |           |                        |      |    |
|                                       |           |           |                        |      |    |
|                                       |           |           |                        |      |    |

RECEIVED


MAR 16 1995

Dept. of Environmental Quality  
Office of Land & Water Resources

IF MORE SPACE IS NEEDED, USE BACK

If well telescopes please  
sketch and show depths.

GROUND LEVEL

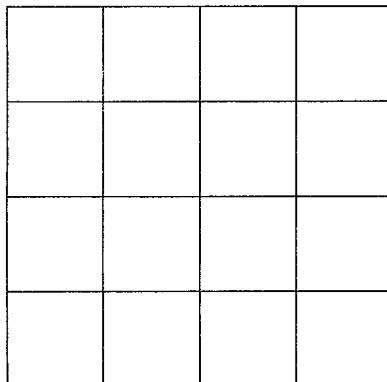

SECTION \_\_\_\_\_

Please indicate well location X.

ADDITIONAL INFORMATION

If more than one screen,  
show location of each on sketch.