

**MISSISSIPPI DEPARTMENT OF ENVIRONMENTAL QUALITY**

Office of Land and Water Resources

P. O. Box 10631  
Jackson, MS 39289-0631  
**WATER WELL DRILLERS LOG**

COUNTY WELL LOCATED <i>Pearl River</i>	
WELL NUMBER <i># 2056</i>	CODED
DATE WELL COMPLETED <i>2-10-95</i>	

PERMIT NUMBER
NAME OF DRILLING FIRM <i>Boone's Water Well</i>

NAME & MAILING ADDRESS OF LANDOWNER <i>Curtis Lozewski</i>			
<i>114 Wildflower Circle</i>			
<i>L'fon</i>			
WELL LOCATION:	SEC <i>3</i>	TOWNSHIP <i>2</i>	RANGE <i>N 14 E</i>
DISTANCE <i>10</i> Miles	DIRECTION <i>SE</i>	NEAREST TOWN <i>L'fon</i>	
OTHER LANDMARK			
WELL PURPOSE ( <input checked="" type="radio"/> Home) Irrigation, Municipal, Industrial, Fish Pond, etc.			

<b>PUMP DATA</b>		
PUMP TYPE (Circle One): Submersible, Turbine, <input checked="" type="radio"/> Jet, Flowing Well, Other (Describe) _____		
POWER TYPE (Circle One): <input checked="" type="radio"/> Electric, Tractor, Diesel, Gasoline, Butane, Other (Describe) _____ H/P <i>1</i>		
Pump Capacity (GPM)	No. of Stages	Setting Depth  FT.
PUMP TEST		
Well yielded _____ GPM with a drawdown of _____ ft. after _____ hours of pumping		

<b>WELL DATA</b>		
Well Depth <i>80</i>	Casing Diameter (In.) <i>2</i>	Casing Length (Ft.) <i>70</i>
Type of Casing <i>nch 40</i>	Hole Depth <i>80</i>	Depth to Static Water Level
TYPE OF COMPLETION: (Circle One or More): <input checked="" type="radio"/> Gravel Packed, Underreamed, Telescoped, Natural Development, Open Hole, Other (Describe) _____		
WELL GROUTED TO A DEPTH OF <i>5</i> FEET Type Grout (circle one): Cement, Bentonite, or Mix		

<b>LOG DATA</b>	
TYPE OF LOG RUN (Circle One): No Log Run, Electric, Gamma Ray, Density, Sonic, Neutron, Other (Describe) _____	
Name of Organization Running Log	

<b>SCREEN DATA</b>		
Diameter - Inches <i>2</i>	Length - Feet <i>10</i>	Slot Size - Inches <i>8</i>
Screen Type <i>nch 40</i>	Depth to Bottom - Feet	


<b>GEOLOGIC DATA (Office Use Only)</b>			
Surface Elev.	Geologic Unit	Unit Thickness	Depth to Top
Subs. SWL	Date	Analysis	Aquifer Test
Driller's Remarks			
Top of Lap Pipe or Reduction in Casing  FEET <input type="checkbox"/> IF TELESCOPED OR MORE THAN ONE SCREEN: USE BACK PAGE			

DESCRIPTION OF FORMATIONS ENCOUNTERED	FROM	TO
<i>Sand</i>	<i>0</i>	<i>80</i>

FORMATIONS (Continued)	FROM	TO
<b>RECEIVED</b>		
<b>JUN 12 1995</b>		
Dept. of Environmental Quality Office of Land & Water Resources		
IF MORE SPACE IS NEEDED, USE BACK		

If well telescopes please  
sketch and show depths.

GROUND LEVEL

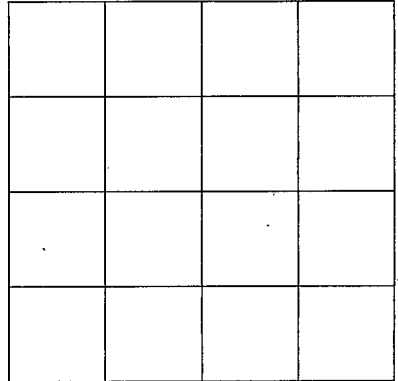

SECTION \_\_\_\_\_

Please indicate well location X.

ADDITIONAL INFORMATION

If more than one screen,  
show location of each on sketch.