

MISSISSIPPI DEPARTMENT OF ENVIRONMENTAL QUALITY
Office of Land and Water Resources

P. O. Box 10631
 Jackson, MS 39289-0631
WATER WELL DRILLERS LOG

COUNTY WELL LOCATED
Pearl River

WELL NUMBER CODED
H-2068

DATE WELL COMPLETED
5-20-2000

PERMIT NUMBER

NAME OF DRILLING FIRM
Boone's Water Well

NAME & MAILING ADDRESS OF LANDOWNER
Dale Rester
916 9 Red Hill Church Rd
Lumberton, MS 39455

WELL LOCATION: SEC TOWNSHIP RANGE
26 2 N 14 E

DISTANCE DIRECTION NEAREST TOWN
7 Miles E of Poplarville

OTHER LANDMARK

WELL PURPOSE: Home Irrigation, Municipal, Industrial, Fish Pond, etc.

PUMP DATA

PUMP TYPE (Circle One):
 Submersible, Turbine, Jet, Flowing Well,
 Other (Describe) _____

POWER TYPE (Circle One):
 Electric, Tractor, Diesel, Gasoline, Butane,
 Other (Describe) _____ H/P 1

Pump Capacity (GPM) No. of Stages Setting Depth
20 _____ FT.

PUMP TEST
 Well yielded _____ GPM with
 a drawdown of _____ ft.
 after _____ hours of pumping

WELL DATA

Well Depth Casing Diameter (In.) Casing Length (Ft.)
160 4 140

Type of Casing Hole Depth Depth to Static Water Level
Sch40 160 80

LOG DATA

TYPE OF LOG RUN (Circle One): No Log Run, Electric, Gamma Ray, Density, Sonic, Neutron, Other (Describe) _____

Name of Organization Running Log

TYPE OF COMPLETION: (Circle One or More):
 Gravel Packed, Underreamed, Telescoped,
 Natural Development, Open Hole, Other
 (Describe) _____

WELL GROUTED TO A DEPTH OF 10 FEET
 Type Grout (circle one): Cement, Bentonite, or Mix

GEOLOGIC DATA (Office Use Only)

Surface Elev.	Geologic Unit	Unit Thickness	Depth to Top
Subs. SWL	Date	Analysis	Aquifer Test

SCREEN DATA

Diameter - Inches Length - Feet Slot Size - Inches
4 20 #8

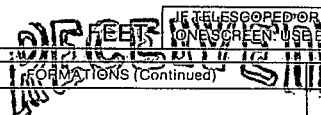
Screen Type Depth to Bottom - Feet
Sch40 _____

Driller's Remarks

Top of Lap Pipe or Reduction in Casing

IF TELESCOPED OR MORE THAN ONE SCREEN USE BACK PAGE

DESCRIPTION OF FORMATIONS ENCOUNTERED	FROM	TO
<u>Sand + gravel</u>	<u>0</u>	<u>70</u>
<u>Clay</u>	<u>70</u>	<u>100</u>
<u>Sand</u>	<u>100</u>	<u>160</u>


SEP 07 2000
 Dept. of Environmental Quality
 Office of Land & Water Resources

IF MORE SPACE IS NEEDED, USE BACK

If well telescopes please
sketch and show depths.

GROUND LEVEL

SECTION _____

Please indicate well location X.

ADDITIONAL INFORMATION

If more than one screen,
show location of each on sketch.