

MISSISSIPPI DEPARTMENT OF ENVIRONMENTAL QUALITY

Office of Land and Water Resources

P. O. Box 10631

Jackson, MS 39289-0631

WATER WELL DRILLERS LOG

COUNTY WELL LOCATED
PEARL RIVER

WELL NUMBER
H-2088

CODED

DATE WELL COMPLETED
7/12/02

PERMIT NUMBER

NAME OF DRILLING FIRM
HARRINGTON DRILLING Co

0564

NAME & MAILING ADDRESS OF LANDOWNER
Ellie Gallardo
15 Campand Rd.
Lumberton, MS 39455

Latitude: **N 30° 51' 09.3"**
Longitude: **W - 89° 24' 18.0"**

WELL LOCATION. SEC TOWNSHIP RANGE
21 T2 N 3 R14 E

DISTANCE DIRECTION NEAREST TOWN
11 Miles S.E. of Lumberton.

OTHER LANDMARK
Corner of Campand + 45 Hwy 26

WELL PURPOSE (Home, Irrigation, Municipal, Industrial, Fish Pond, etc.)
(Home)

PUMP DATA

PUMP TYPE (Circle One):
Submersible, Turbine, Jet, Flowing Well.

POWER TYPE (Circle One):
Electric, Tractor, Diesel, Gasoline, Butane, Other (Describe) **H/P 1HP**

DESCRIPTION OF FORMATIONS ENCOUNTERED	FROM	TO
Red sandy clay	0	18
Red fine grain sand	18"	45"
Red clay	45"	60"
1/2" bit of clay	60'	129'
fine sand	129'	140'
1/2" bit of clay	140'	180'
fine white sand	180'	200'
med grain white sand	200'	220'

WELL DATA

Well Depth 220'	Casing Diameter (In.) 4"	Casing Length (Ft.) 200'
Type of Casing PVC	Hole Depth 220'	Depth to Static Water Level 110'

TYPE OF COMPLETION: (Circle One or More):
 Gravel Packed, Underreamed, Telescoped,
 Natural Development, Open Hole, Other
 (Describe)

WELL GROUTED TO A DEPTH OF **25** FEET
 Type Grout (circle one): Cement, Bentonite, or Mix

SCREEN DATA

Diameter - Inches 4"	Length - Feet 20'	Slot Size - Inches .008
Screen Type PVC SAWED	Depth to Bottom - Feet 220'	

RECEIVED

AUG 21 2002

BY: OLWR

Top of Lap Pipe or Reduction in Casing

FEET IF TELESCOPED OR MORE THAN ONE SCREEN: USE BACK PAGE


I certify that the well was drilled, constructed and completed in accordance with all applicable Requirements of the Mississippi Department of Environmental Quality and/or the Mississippi Department of Health regulations and state laws.

Al Harrington **0564** **8/10/02**
 Signature of Licensed Driller and License No. Date

Additional Information Required On Back

If well telescopes please sketch and show depths.

GROUND LEVEL

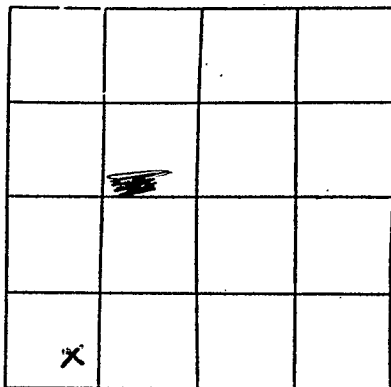

SECTION 31

Please indicate well location X.

Pump Capacity (GPM)	No. of Stages	Setting Depth
<u>126PM</u>		<u>160'</u> FT.

PUMP TEST

Well yielded _____ GPM with
a drawdown of _____ ft.
after _____ hours of pumping

LOG DATA

TYPE OF LOG RUN (Circle One): No Log Run.
Electric, Gamma Ray, Density, Sonic, Neutron,
Other (Describe) _____

Name of Organization Running Log

GEOLOGIC DATA (Office Use Only)

Surface Elev.	Geologic Unit	Unit Thickness	Depth to Top
Subs. SWL	Date	Analysis	Aquifer Test

Driller's Remarks

Miocene

If more than one screen,
show location of each on sketch.