

MISSISSIPPI DEPARTMENT OF NATURAL RESOURCES
Bureau of Land and Water Resources
 Southport Mall
 P.O. Box 10631
 Jackson, Mississippi 39209
WATER WELL DRILLERS LOG

Remember
~~550~~
 9-26-85

9/26 1985 Pentontson Pearl River
 date well completed firm name county well located

LANDOWNER: *John Hickell*
 R.T. Carrier Miss
 description of formations encountered
 White shale from 0240
 Gray sand 240 303

(mailing address)

WELL LOCATION:
 sec. 35 T 3 N R 18 E
 8 miles W of Carrier
 (distance) (direction) (nearest town)

WELL PURPOSE: *Home*
 (home, irrigation, municipal, industrial)

WELL COMPLETION DATA:

- (1) diameter (inches) 4"
- (2) total depth (feet) 305
- (3) static water level (feet) 130 below top of ground.
- (4) casing PVC (material), 305 (depth)
- 70 (size) if telescope see back.
- (5) screen 10 (length), 295 (depth to top)
- 10 (size), PCC (material)
- (6) pump 1 (HP), 950 (yield gpm)
- Elect (type power)
- (7) electric log no (yes or no)

(organization running log)

(8) how well bottom plugged *Seal*
Shurt


DRILLERS REMARKS:

RECEIVED
 NOV 2 0 1985

Department of Natural Resources
 Bureau of Land & Water Resources

If well telescopes please sketch and show depths.

GROUND LEVEL

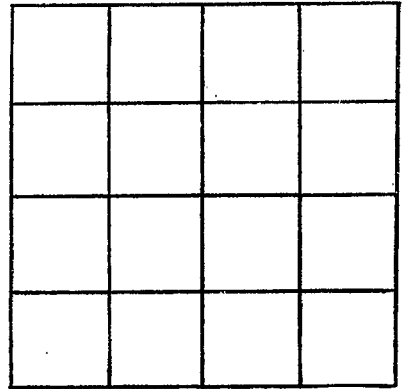

SECTION _____

Please indicate well location X.

ADDITIONAL INFORMATION

A series of horizontal lines for entering additional information.

If more than one screen, show locations of each on sketch.