

CODED

MISSISSIPPI
BOARD OF WATER COMMISSIONERS
416 North State Street
Jackson, Mississippi 39201

WATER WELL DRILLERS LOG

Pearl River
J2
1-6-69

1-6 date well completed
1969 Penton Well Serv firm name
Pearl River county well located

LANDOWNER: C.A. Post
5643 Pratt Drive
New Orleans La -
(mailing address)

description of formations encountered	from	to
	Red Clay	0
White Clay	8	85
Silt	85	118
Blue Mud	118	185
Sand	185	300
Blue Clay	300	348
Grey Sand	348	445
Blue Clay	445	488
Grey Sand	488	531

WELL LOCATION:
sec. 35 T. 3 S. R. 18 E. W.
3 miles South of Crossroads
(distance) (direction) (nearest town)

WELL PURPOSE: Home
(home, irrigation, municipal, industrial)

WELL COMPLETION DATA: 4 1/2 Drilled

- (1) diameter (inches) 2"
- (2) total depth (feet) 531
- (3) static water level (feet) 101 below top of ground.
- (4) casing Galv. 526 (material) (depth)
2" (size) if telescope see back.
- (5) screen 5' 526 (length) (depth to top)
2" S. Steel (size) (material)
- (6) pump 1 1/2 9 (HP) (yield gpm)
Elec (type power)
- (7) electric log NO (yes or no)
- (organization running log)

(8) how well bottom plugged B w Valve

DRILLERS REMARKS:


CODED

JAN 21 1969

MISS. BD. OF
WATER COM.

If well telescopes please sketch and show depths.

GROUND LEVEL

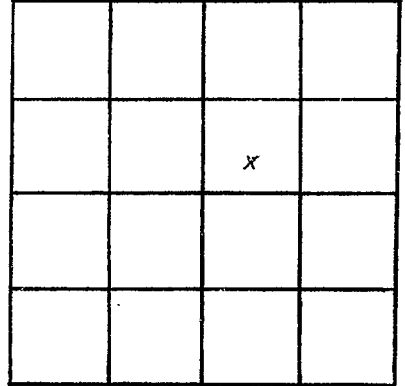

SECTION 35

Please indicate well location X.

ADDITIONAL INFORMATION

If more than one screen, show locations of each on sketch.