

PEARL RIVER
 T 3
 5-8-71

MISSISSIPPI
 BOARD OF WATER COMMISSIONERS
 416 North State Street
 Jackson, Mississippi 39201

CODED

WATER WELL DRILLERS LOG

5-8 1971 Esley Stafford Well Service Pearl River
 date well completed firm name county well located

LANDOWNER: J. J. Donnavol

533 Amelia St

Quatna La
 (mailing address)

WELL LOCATION:

sec 23 T 3 S R 18 E W
 2 miles South of Crossroad
 (distance) (direction) (nearest town)

WELL PURPOSE:

(home, irrigation, municipal, industrial)

WELL COMPLETION DATA:

- (1) diameter (inches) 4
- (2) total depth (feet) 266
- (3) static water level (feet) 180 below top of ground.
- (4) casing Plastic, 256 (material) (depth)
- 4 in if telescope see back. (size)
- (5) screen 10, 256 (length) (depth to top)
- 4, Plastic (size) (material)
- (6) pump 1, 800 (HP) (yield gpm)
- Elec (type power)
- (7) electric log (yes or no)
- (organization running log)
- (8) how well bottom plugged B.W.V.

description of formations encountered

from

to

Clay

1

35

Chalk

35

200

Sand + Pea Gravel

200

266

CODED

NOV 21 1971


MISS. BD. OF
 WATER COM.

DRILLERS REMARKS:

Charles Stafford

If well telescopes please sketch and show depths.

GROUND LEVEL

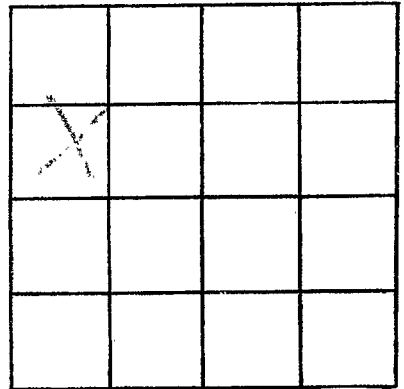

SECTION _____

Please indicate well location X.

ADDITIONAL INFORMATION

If more than one screen,
show locations of each on sketch.