

Pearl R.
J-4
9-23-60

WATER WELL DRILLERS LOG

CODED

F-301
CODE

Date: 9-23, 1960, Driller: Wicket Bruce County: P.R.
(Name)

(1) Owner of Land: Herman Seal
(Name)
Poplarville Miss.
(Address)

(2) Location: 1/4, 1/4, Sec. 14 T3R6,
12 miles west of Poplarville
(distance) (direction) (Nearest Town)

(3) Topography: X
(Hilly) (Flat) (Level)

(4) Purpose of Well: Domestic
(Domestic Irrigation
Municipal, Industrial, Other)

Description & Color of Materials Sand, Clay, Red Clay, Shell, etc.	Thick- ness Feet	Depth Feet
<u>Surface Sand + gravel</u>	<u>0</u>	<u>80</u>
<u>Muck clay</u>	<u>80</u>	<u>315</u>
<u>Fine sand</u>	<u>315</u>	<u>360</u>
<u>Hard Blue Clay</u>	<u>360</u>	<u>440</u>
<u>Good sand</u>	<u>440</u>	<u>515</u>

Information upon completion of well:

(1) Diameter 2 inches.

(2) Total Depth 515 feet.

(3) Water Level Flow feet below top of ground.

(4) Cased to _____, Size _____

(5) Screen: Size 2", Length 10'


(6) Were any formations sealed against pollution?
_____ yes, _____ X no.

If YES depth of formation _____

Why _____

Drillers Remarks: Good flow.
Well was located at
Cross Roads Miss.

CODED

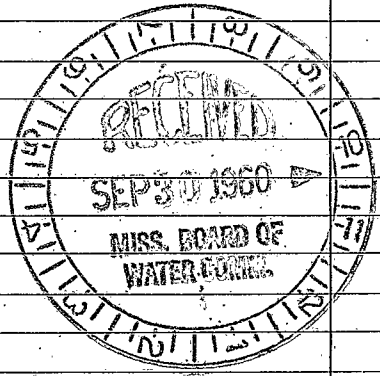

19

(Use Back Side)

Well No.

